


T.1N., R.3W., W.M.

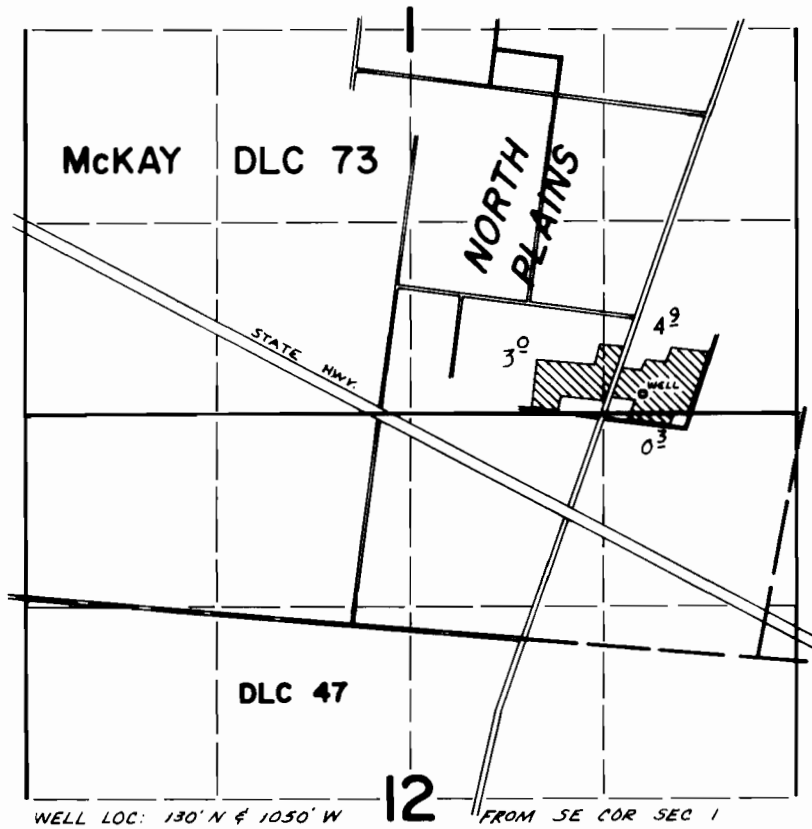

**FINAL PROOF SURVEY**  
UNDER

Application No. G-5821 Permit No. G-5027  
IN NAME OF

LLOYD E. LaMORDDEN

Surveyed Oct. 7 1975, by D. Norby