


T.10S., R.4W., W.M.

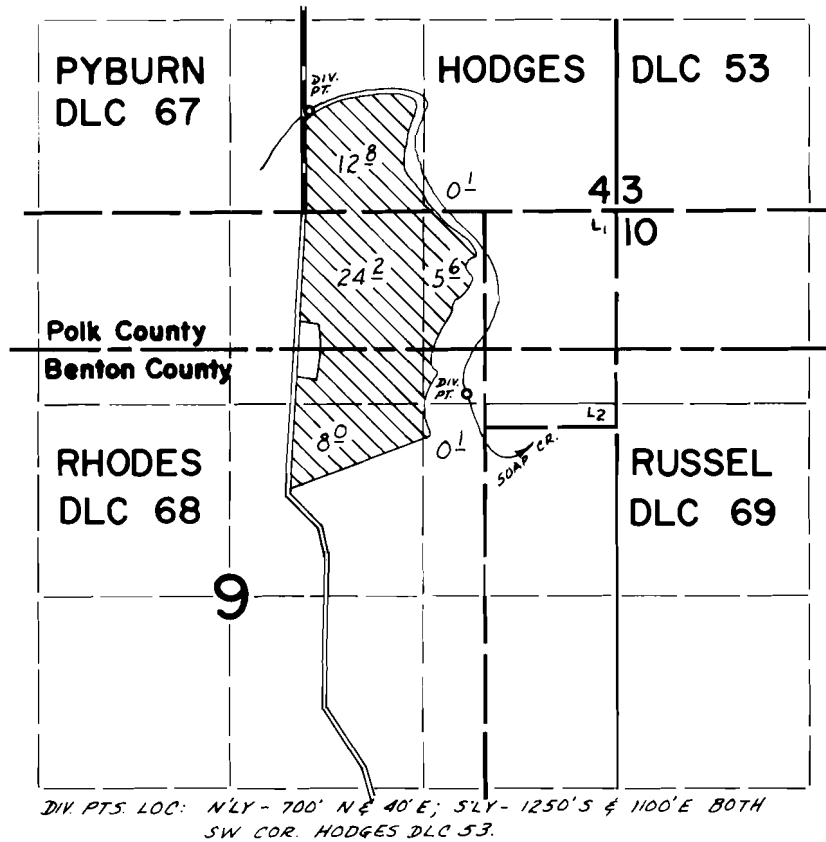

FINAL PROOF SURVEY UNDER

Application No. 45041 Permit No. 33663
IN NAME OF

LAVERN LEPPIN

Surveyed June 9 1975, by D. Norby