


T.7S. R.3W. W.M.

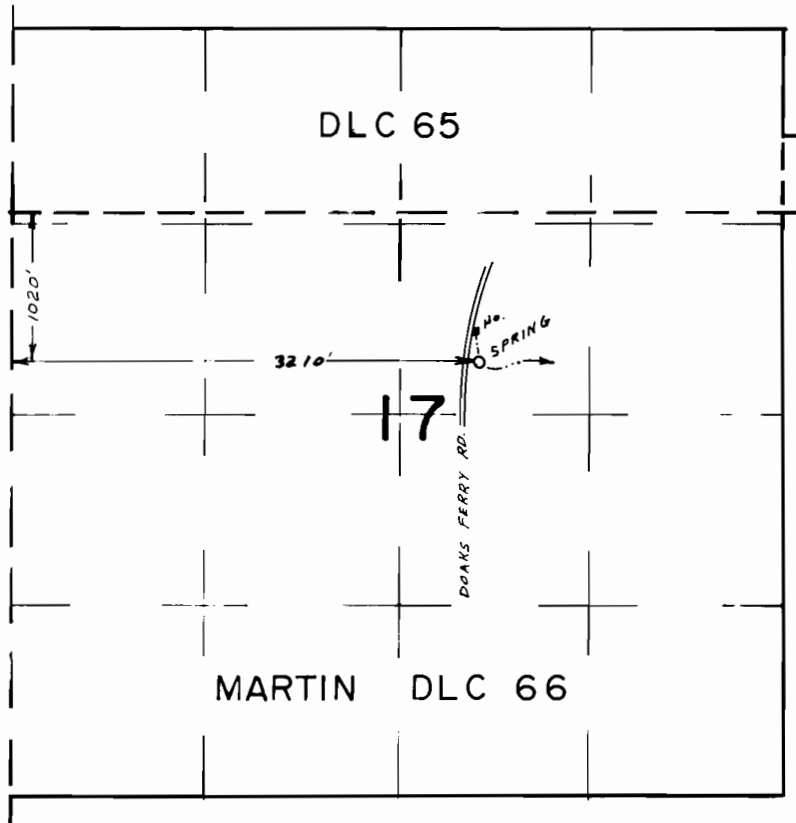

**FINAL PROOF SURVEY**  
UNDER

Application No. 46856 Permit No. 35033  
IN NAME OF

WALTER ERBELE

Surveyed APR. 14, 1975, by L. H. NUNN