


T.8S., R.5W., W.M.

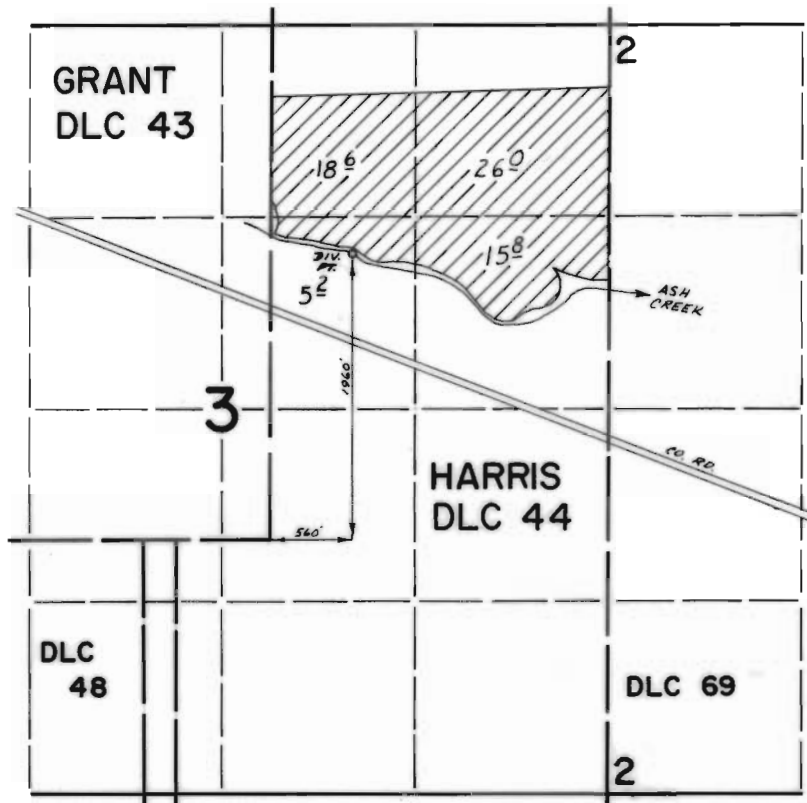

FINAL PROOF SURVEY
UNDER

Application No. 47754 Permit No. 35769
IN NAME OF

CARL A. GERLINGER

Surveyed July 1, 1975, by D. Norby