


G-4660  
45082

# T.6.N. R.36E. W.M.

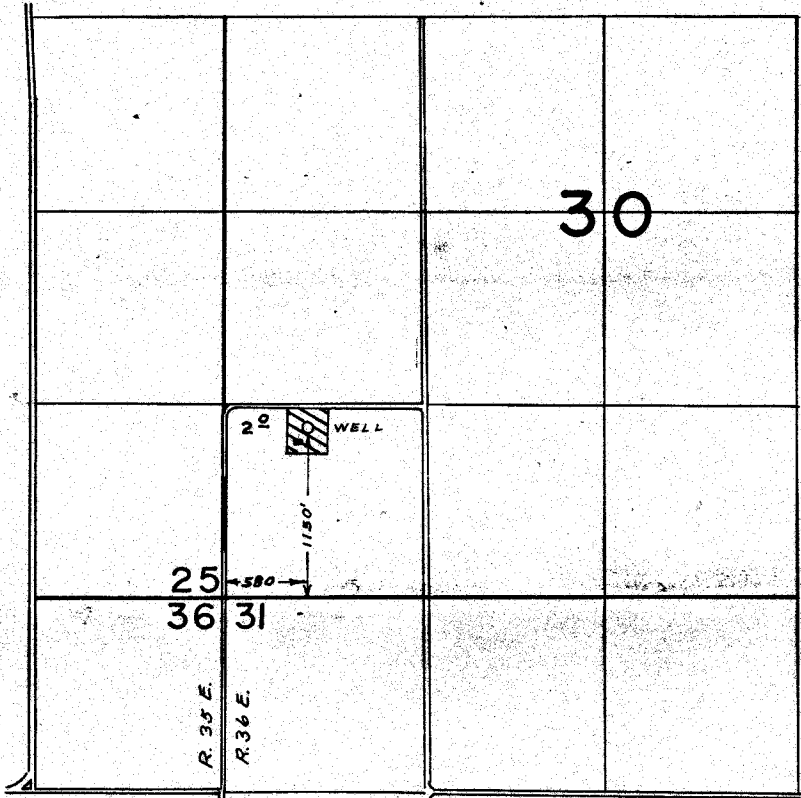

## FINAL PROOF SURVEY UNDER

Application No. G-4936. Permit No. G-4660.  
IN NAME OF

*Ralph E. & Cathy A. Wiese*

Surveyed APR. 7, 1975, by L.H. NUNN