



T.6N. R.34E. W.M.

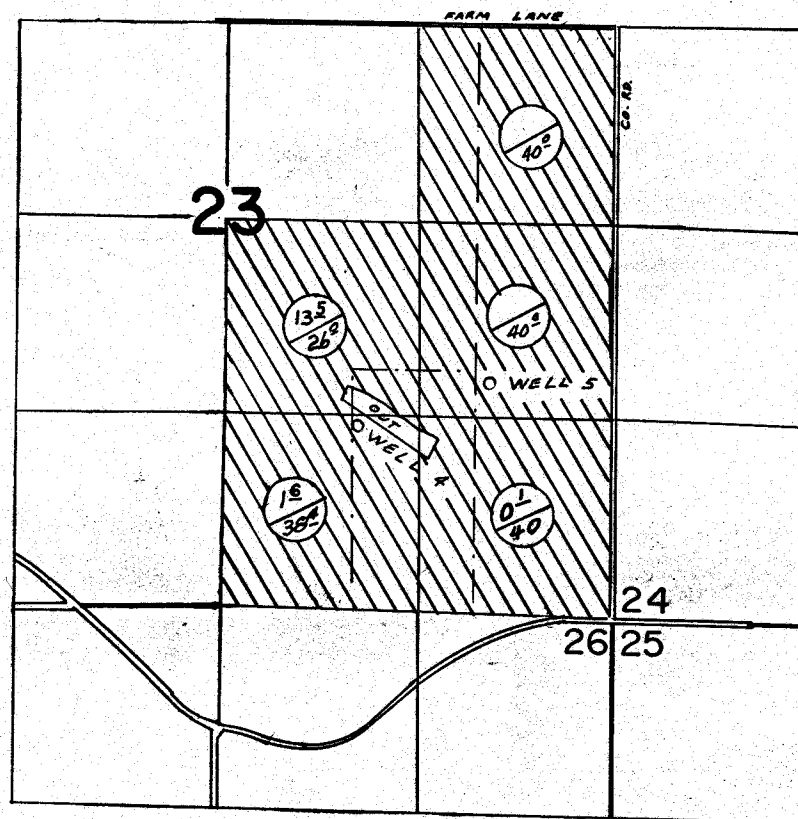

WELL 4 - 1320' N. & 1750' W.; WELL 5 - 1620' S. & 830' W.
BOTH FROM SE COR. SEC. 23.

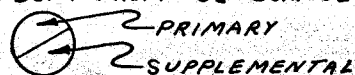

FINAL PROOF SURVEY

UNDER

Application No. G-5811..... Permit No. G-5019.....
IN NAME OF

.....HOWARD L. MULLER.....

Surveyed APR. 3..... 1975., by L.H. NUNN.....