


# T.3S. R.30E. W.M.

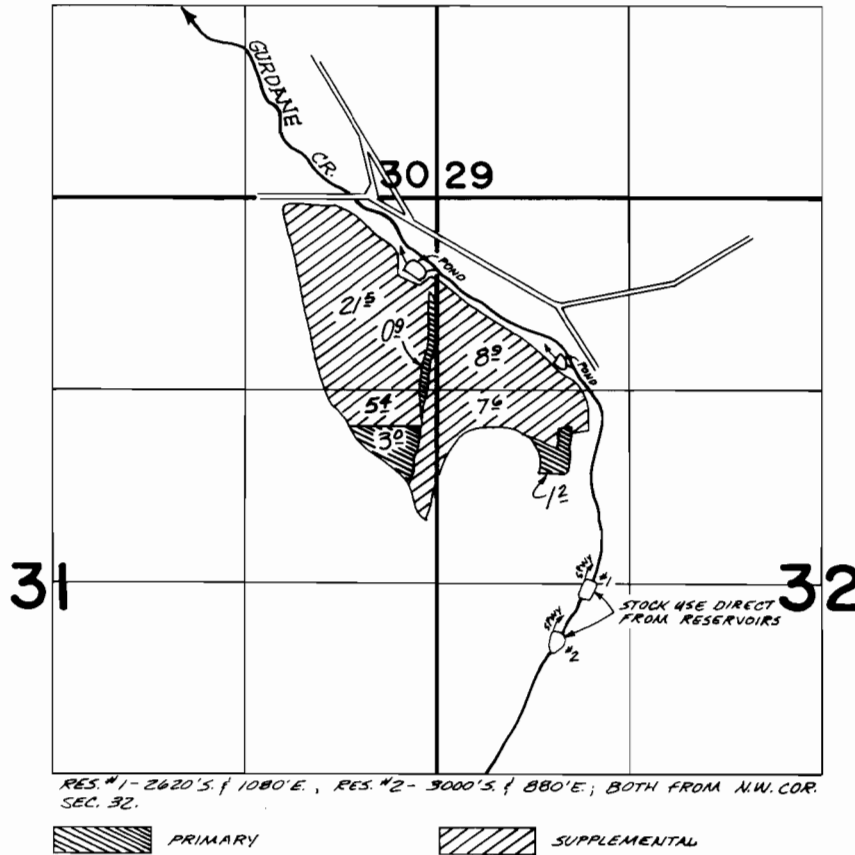

## FINAL PROOF SURVEY UNDER

R 45328 R5352  
 Application No. 45257 Permit No. 33802  
 IN NAME OF

Con Doherty

Surveyed QCT. 22. 19.75. by D. NORBY