


T.2N. R.33E. W.M.

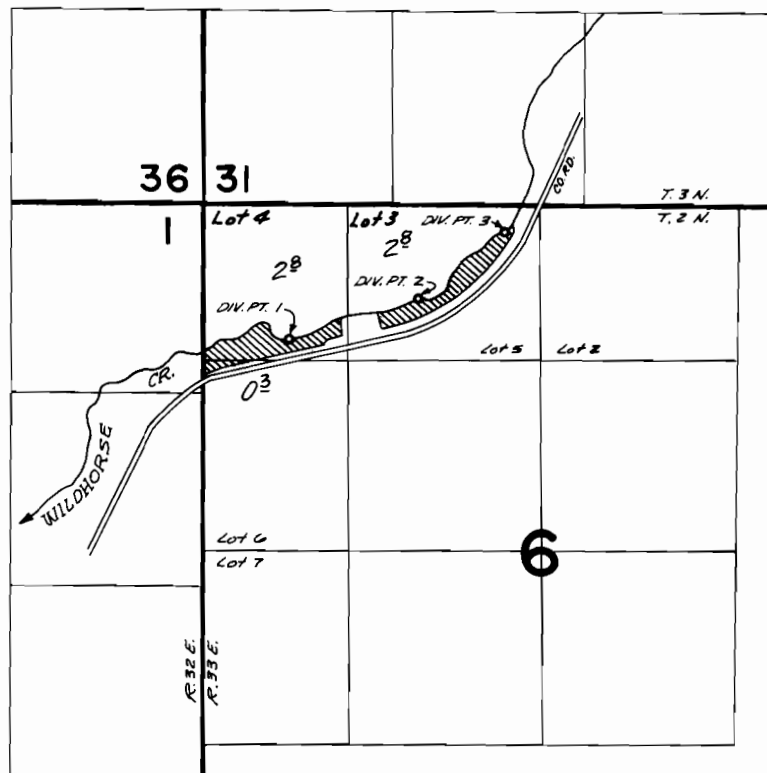

DIV. PT. 1, 940'S. & 600'E., DIV. PT. 2, 660'S. & 1460'E., DIV. PT. 3, 180'S. & 2060'E.
ALL FROM THE N.W. CORNER OF SECTION 6.

FINAL PROOF SURVEY
UNDER

Application No. 45950 Permit No. 34324
IN NAME OF

Marian Karren

Surveyed Oct. 15 1975, by D. Norby