


T.6N. R.38E. W.M.

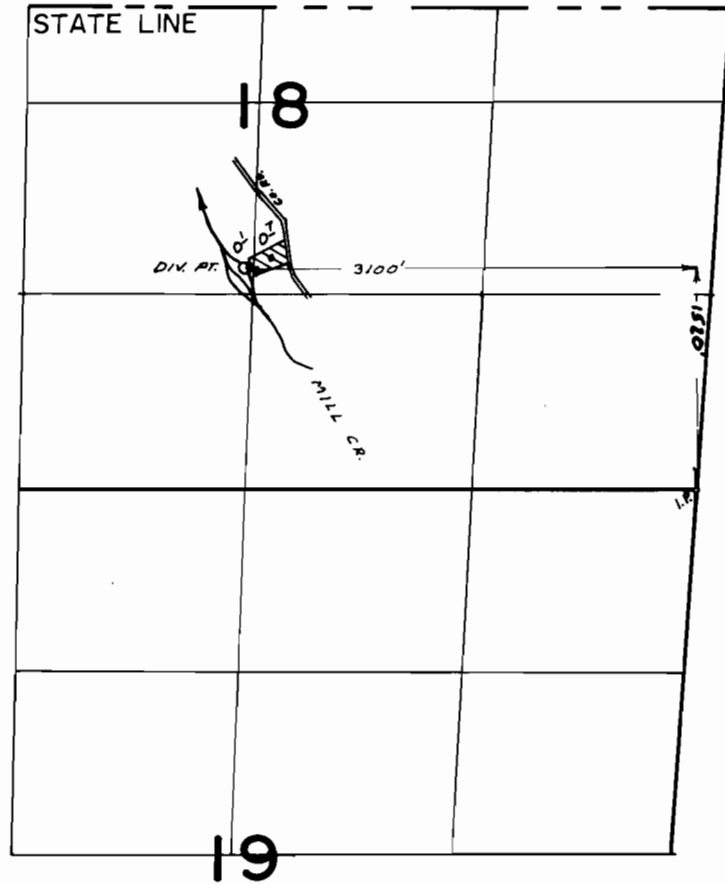

FINAL PROOF SURVEY
UNDER

Application No. 48396... Permit No. 35697...
IN NAME OF

..... ROBERT RITTENHOUSE

Surveyed APR. 7... 1975., by L.H. NUNN