


T.6N.R.34E.W.M.

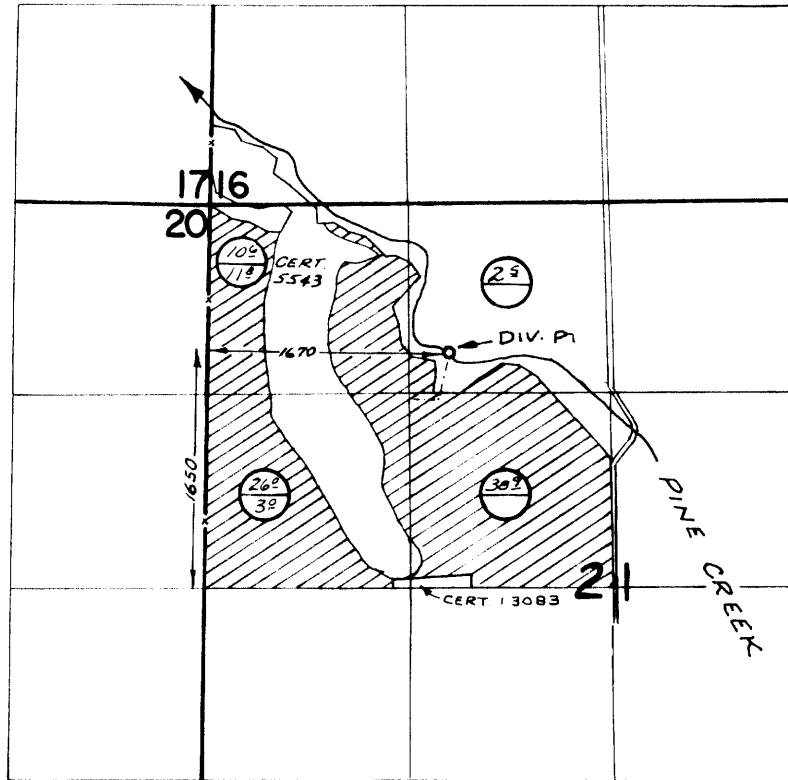

⊖ PERMIT 29850
⊖ PERMIT 37588

FINAL PROOF SURVEY UNDER

Application No. 49970 40042 Permit No. 37588 29850
IN NAME OF

MERLE H. YOUNG

Surveyed Aug. 27, 1971, by G. BACA
Oct. 21, 1975 D. NORBY