


# T.2N. R.34E. W.M.

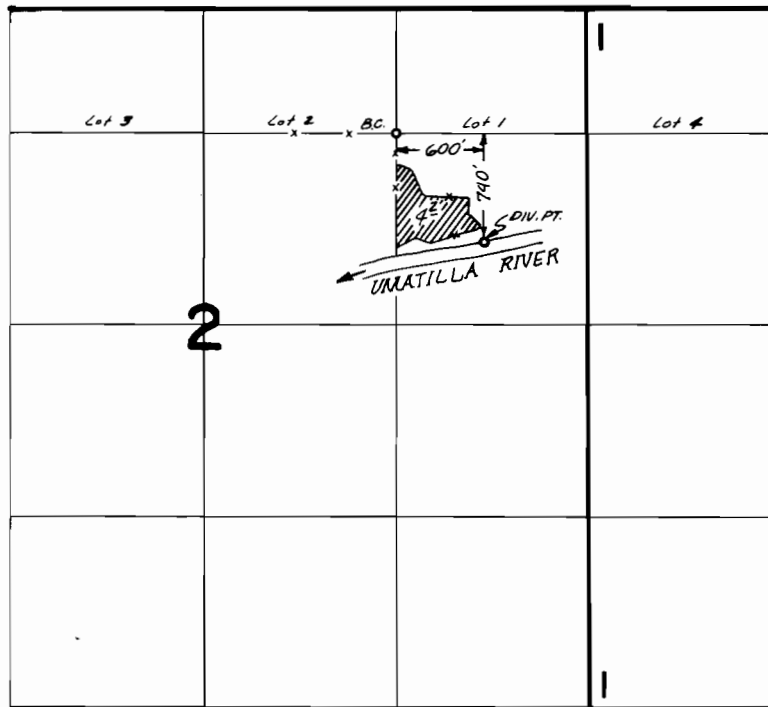

## FINAL PROOF SURVEY UNDER

Application No. 50045 Permit No. 37619  
IN NAME OF

James & Karen Morrow

Surveyed Oct. 18 1975, by D. Norby