T. 2 N. R. 33 E. W.M.

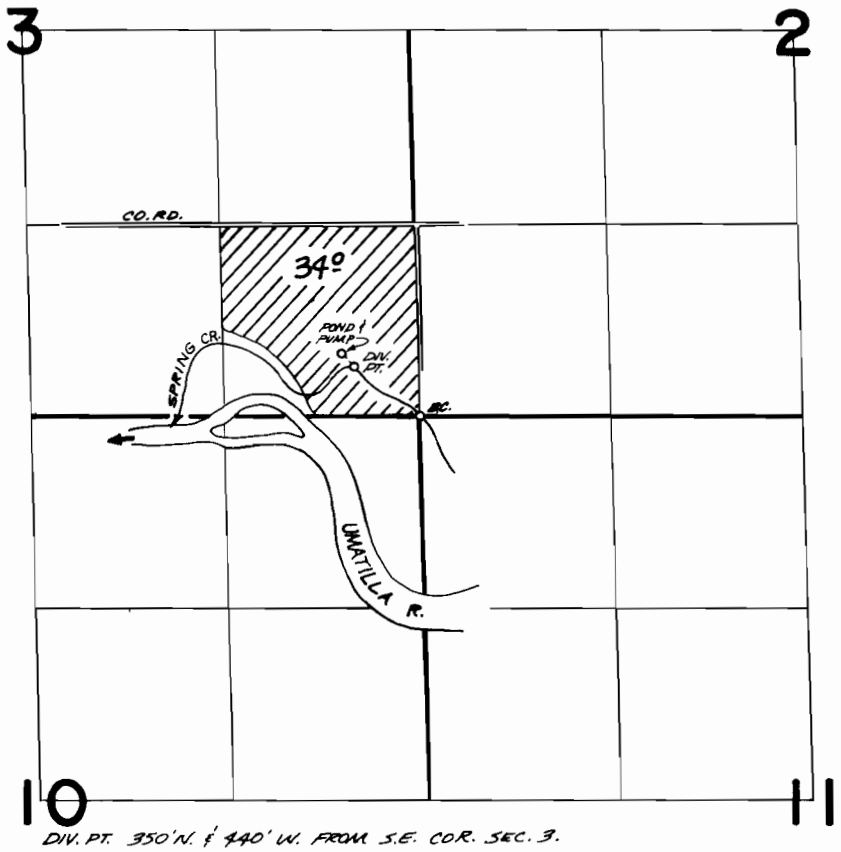

FINAL PROOF SURVEY
UNDER

Application No. 51623 Permit No. 37739
IN NAME OF

Milton Perry

Surveyed Oct. 18 1975, by D. Norby

NZ 2MM 61 CRK