


T. 6 S. R. 2 W. W. M.

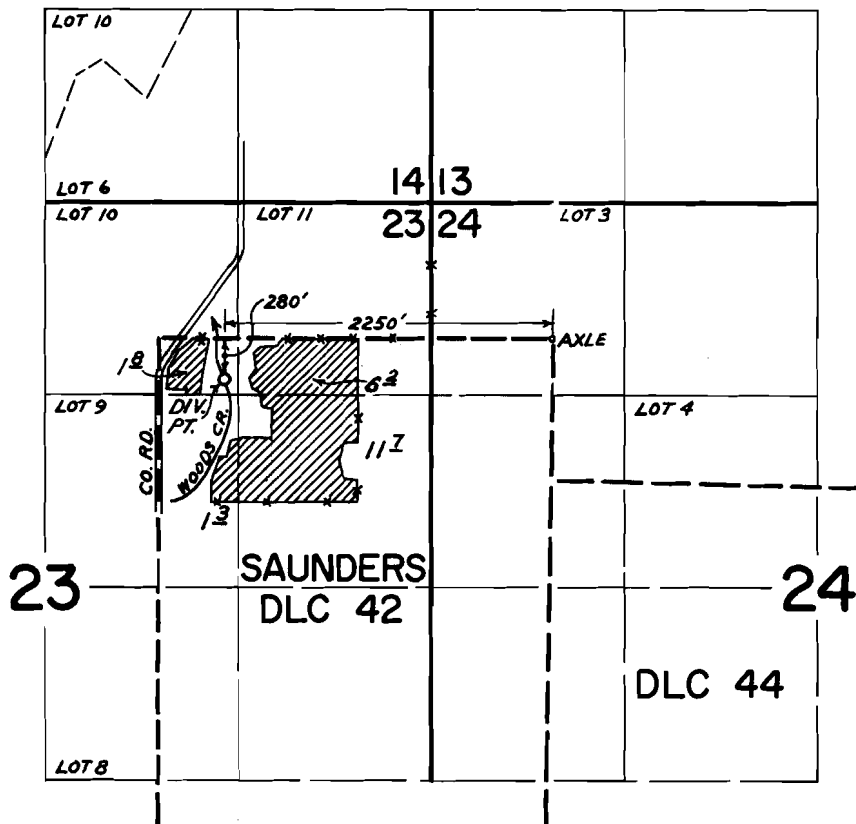

FINAL PROOF SURVEY  
UNDER

Application No. 45479 Permit No. 33939   
IN NAME OF

ALBA McCOLLUM

Surveyed JULY 28 1971, by GREG BACA