


T. 4 S. R. 4 0 E. W. M.

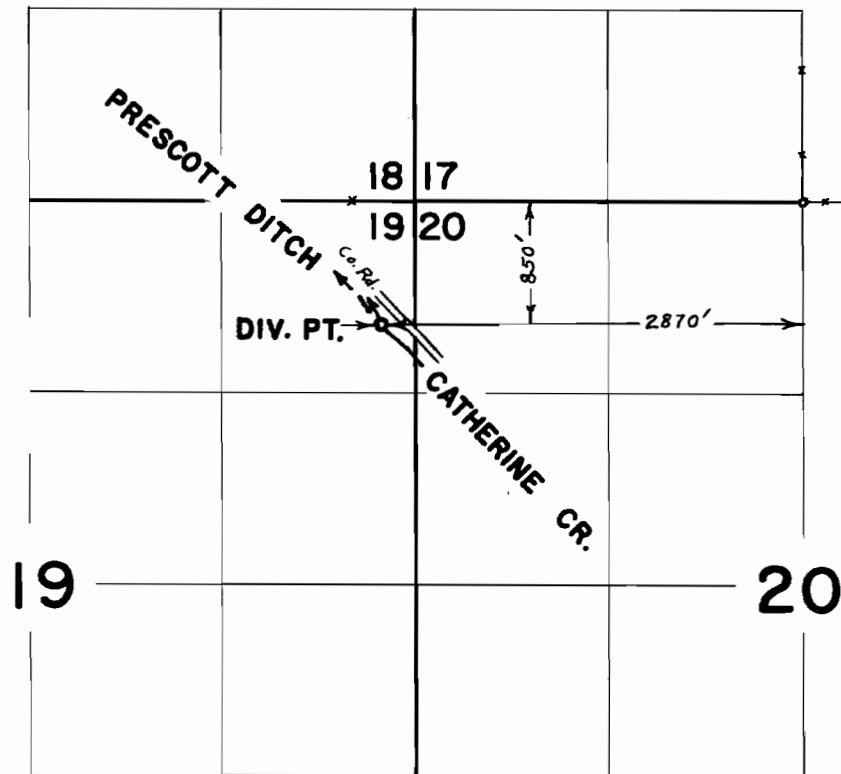

**FINAL PROOF SURVEY**  
UNDER

TRANSFER NO. P.-80  
Application No. .... Permit No. ....  
IN NAME OF  
**PRESCOTT DITCH COMPANY**

Surveyed Aug. 27, 1968, by L. E. Gould.