


T. 5S. R. 1W. W.M.

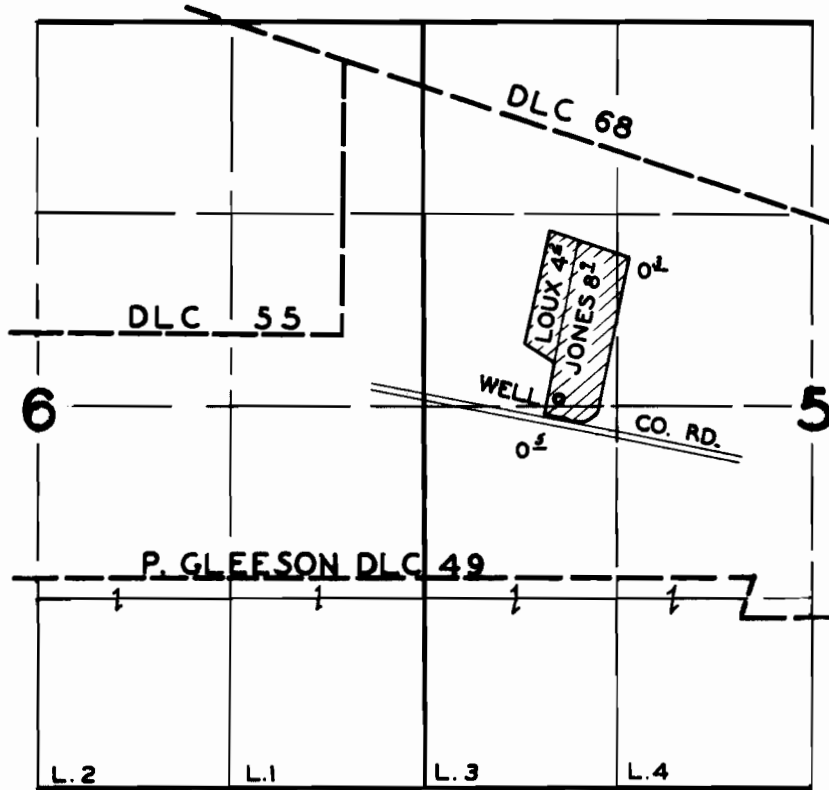

**FINAL PROOF SURVEY**  
UNDER

Application No. G.874 Permit No. G.825  
IN NAME OF

ORVILLE E. LOUX & C. J. JONES

Surveyed MAY 19 1960, by G. O. BARTELS