


T.4S.,R.39E.,W.M.

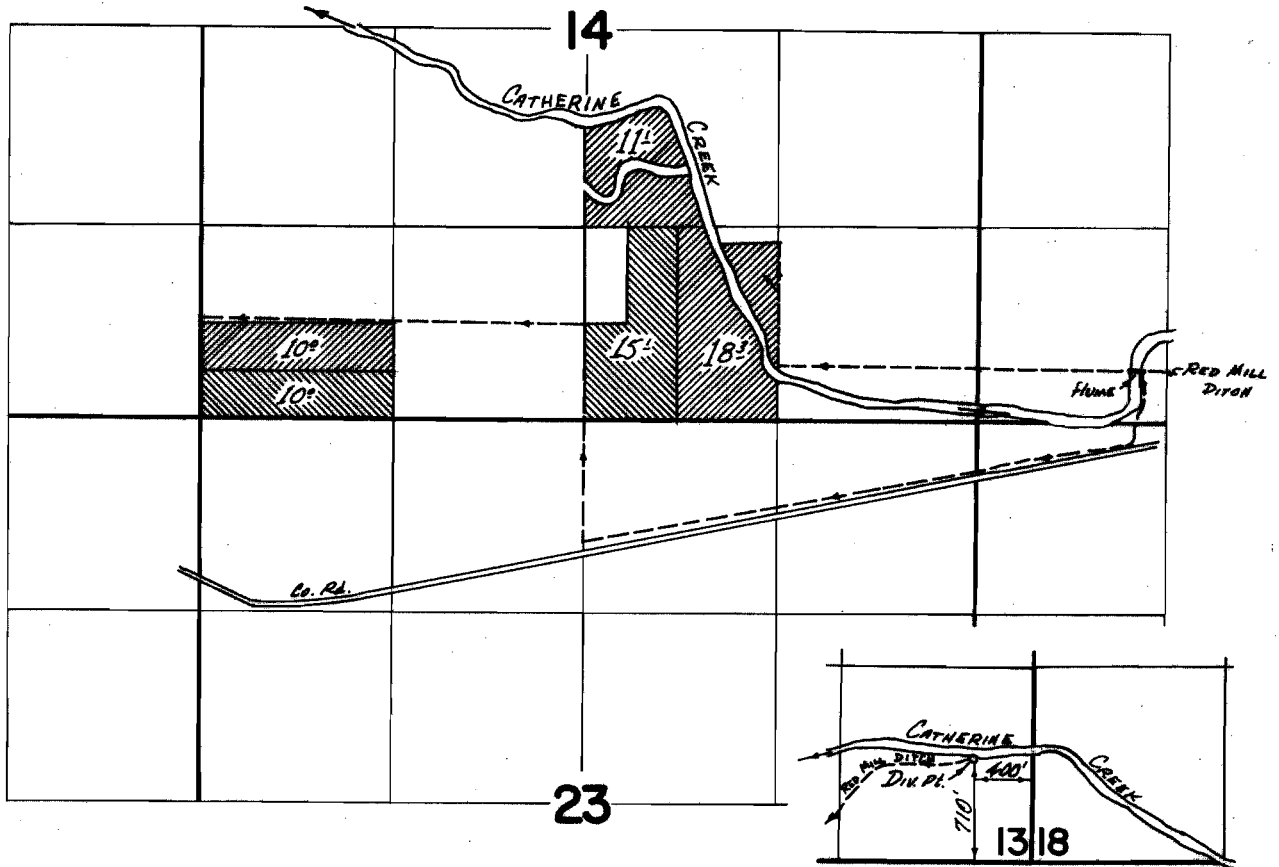

FINAL PROOF SURVEY
UNDER

Transfer No. S-205
S-206

Application No. 44957 Permit No. 34068

IN NAME OF

R. A. CREIGHTON

Surveyed July 14, 1973, by D. Norway