


C-44939
C-44938
P-29034
45113

T.14S., R.31E., W.M.

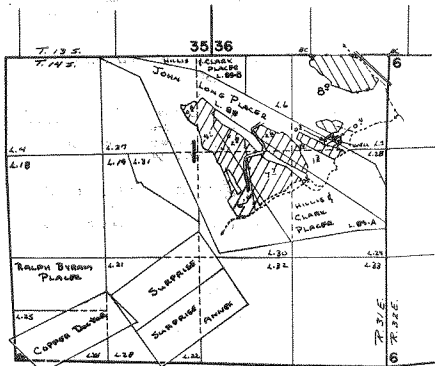

- LAND COVERED BY A# 38959
- LAND COVERED BY A# 65300
- LAND COVERED BY A# 49358

Well Loc: 1160' S 4780' W FROM NE COR SEC 1

Big. Dog Cr. Dv: 3590' S AND 5940' E } FROM NE COR SEC 7 T.14S., R.31E., W.M.

Little Dog Cr. Dv: 330' S AND 100' W

SEE FILE # 38157 FOR WELL LOCATING BIG DOG + L. PINE DRY PDS.

FINAL PROOF SURVEY UNDER

38959
G-5300

29034
G-5131

C-45113
C-44937
C-44938

Application No. 49358 Permit No. 37001
IN NAME OF

ROBIN & EILEEN A. SHEEDY

Surveyed Aug. 27, 1975, by L. Tall