


T.1N. R.48E. W.M.

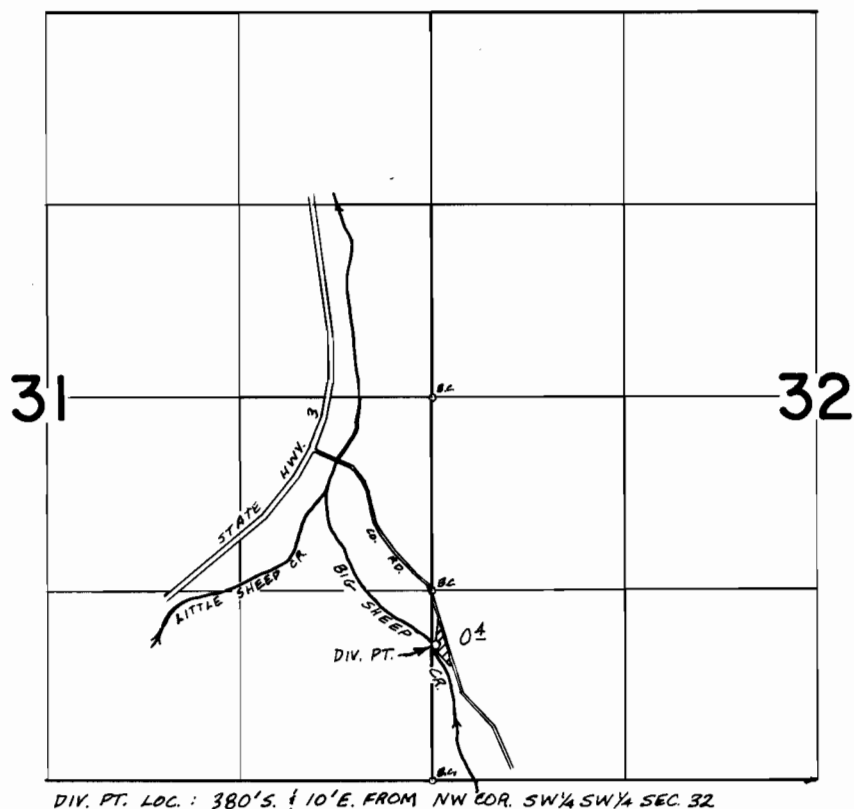

DIV. PT. LOC. : 380'S. & 10'E. FROM NW COR. SW 1/4 SW 1/4 SEC. 32

FINAL PROOF SURVEY
UNDER

Application No. 49261 Permit No. 36921
IN NAME OF

MILTON & CLAUDIA KILLOUGH

Surveyed OCT. 30 1975, by L. H. NUNN