


T. 1 N., R. 13 E.

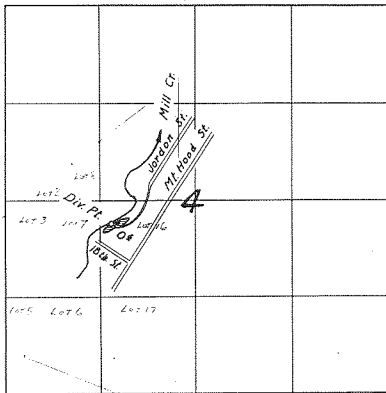

FINAL PROOF SURVEY
UNDER

Application No. 5941..... Permit No. 3690.....
IN NAME OF

.....
Surveyed May 2, 1963, by *S. W. Johnson*