


T.1N. R.3W. W.M.

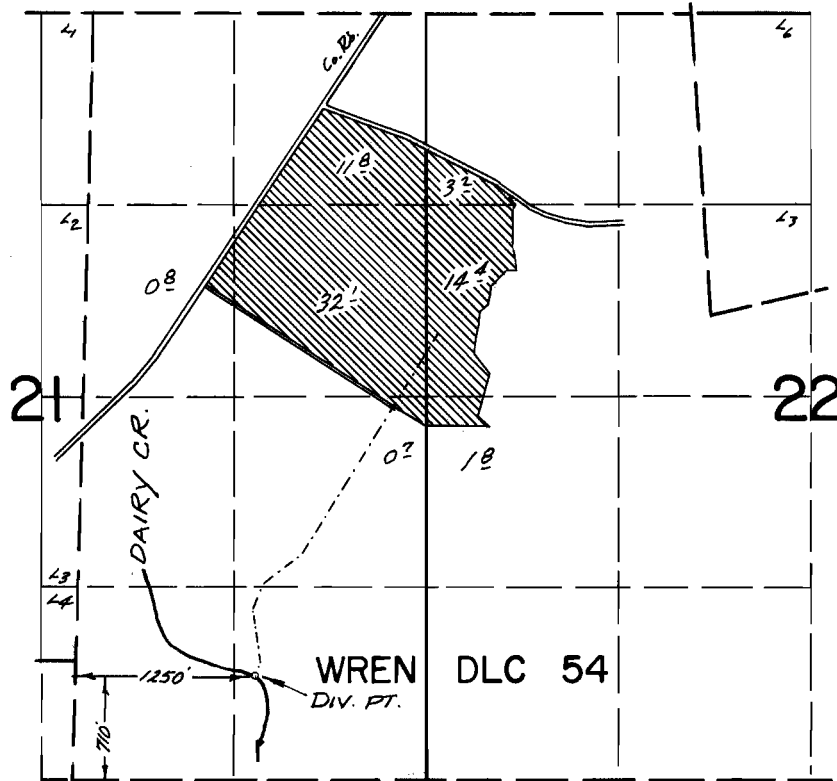

FINAL PROOF SURVEY
UNDER

Application No. 48288.. Permit No. 36239..
IN NAME OF

.....ROLAND G. DUYCK.....

Surveyed April 3, 1974, by R. G. MUCKEN