


# T.5 S.R.7W.W.M.

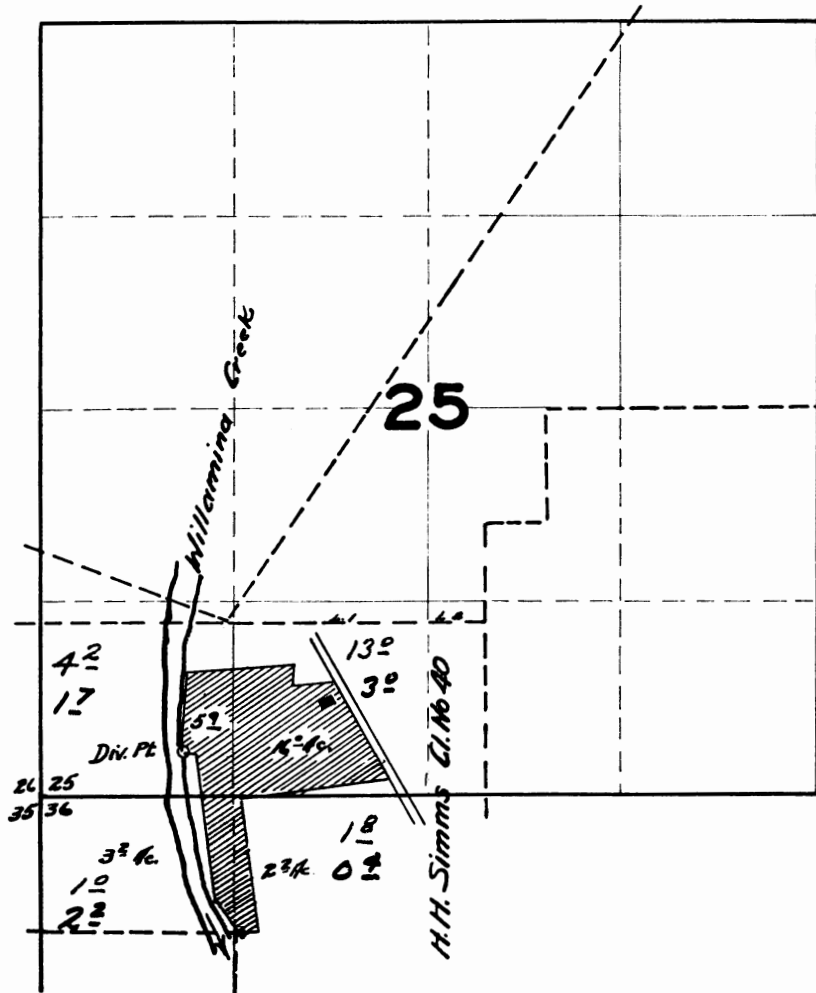

20<sup>0</sup> Ac. under  
Cert #16791.

7<sup>3</sup> Ac. to be under  
right that was  
evidenced by  
Cert #19867.  
2.7 Ac. to be  
canceled.

## FINAL PROOF SURVEY

UNDER

Application No. 22845 Permit No. 17967.

IN NAME OF

VERNON D. RIGGLE

Surveyed 10./2 1951., by H. L. COFFMAN