


T. 5 S. R. 5 W. W.M.

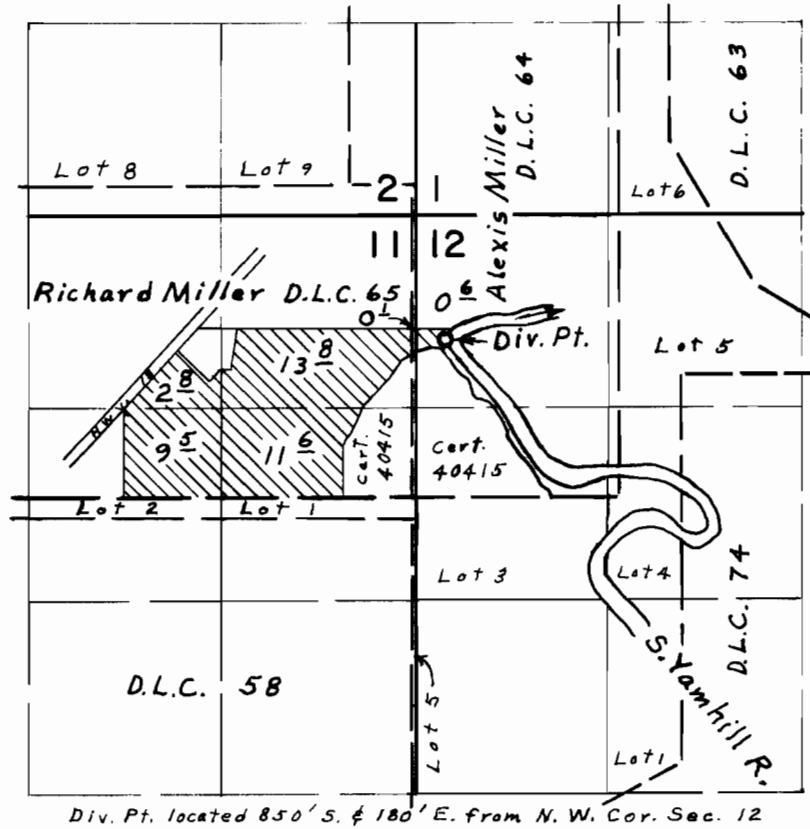

FINAL PROOF SURVEY
UNDER

Application No. 49342. Permit No. 36991
IN NAME OF

.....*Charles O. & Vivian E. Headd*.....

Surveyed Sept. 3, 1975, by *L. E. Gould*.