


5
T.2S.R.4E.WM

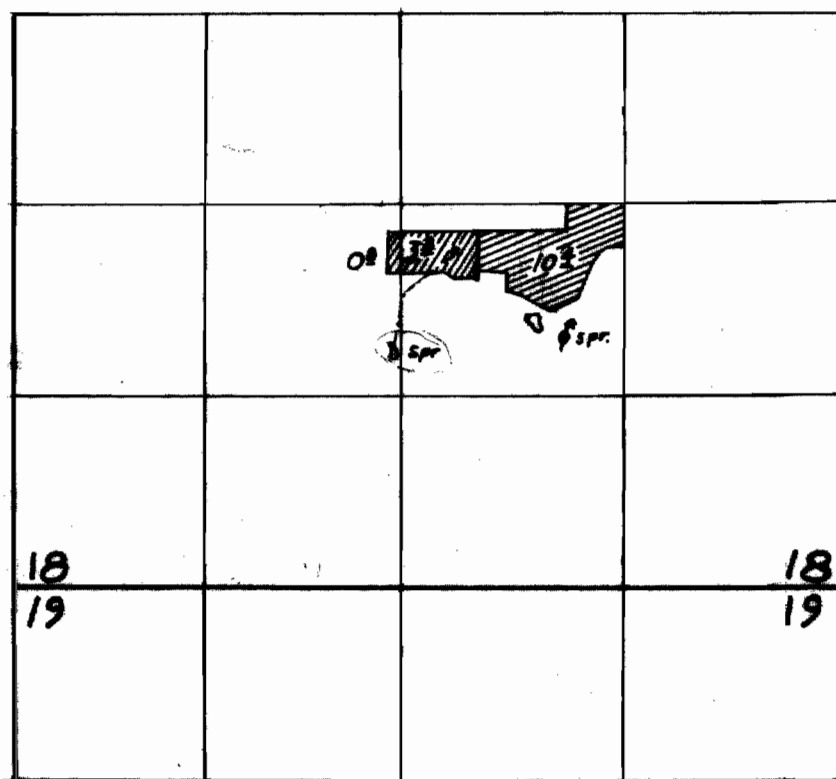

FINAL PROOF SURVEY
UNDER

Application No. 14529... Permit No. 10554...
IN NAME OF

.....*Amanda I. Lowe*.....

Surveyed Jun 14... 1956, by *R.M. Whitby*...