


T.1 S. R.4 E. W.M.

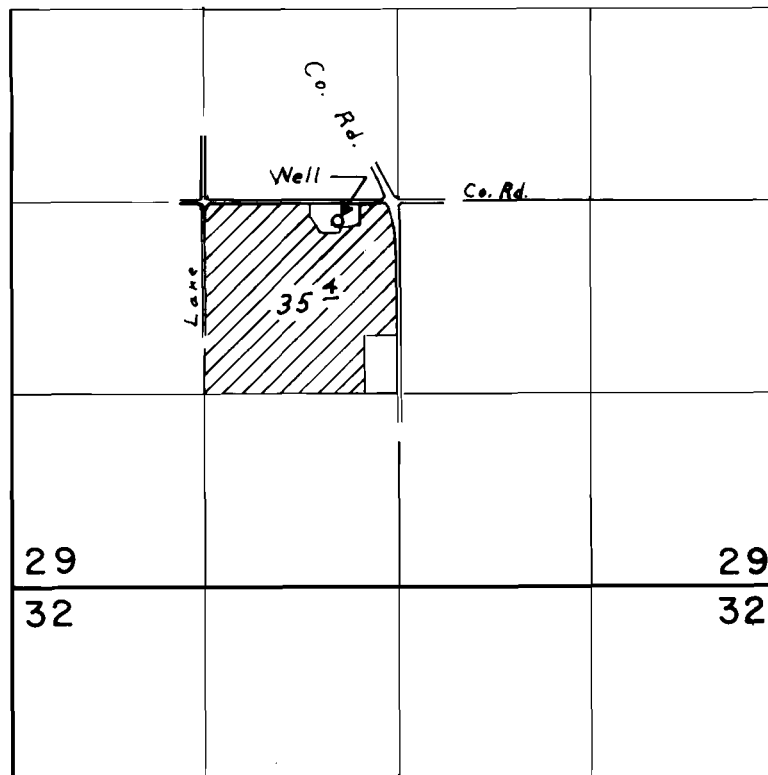

Well located 130' S. & 410' W. from Center Sec. 29

FINAL PROOF SURVEY
UNDER

Application No. G-5391. Permit No. G-5318.
IN NAME OF

HANS NELSON

Surveyed Oct. 5, 1976, by L. E. Gould