


T. 4 S. R. 1 E. W. M.

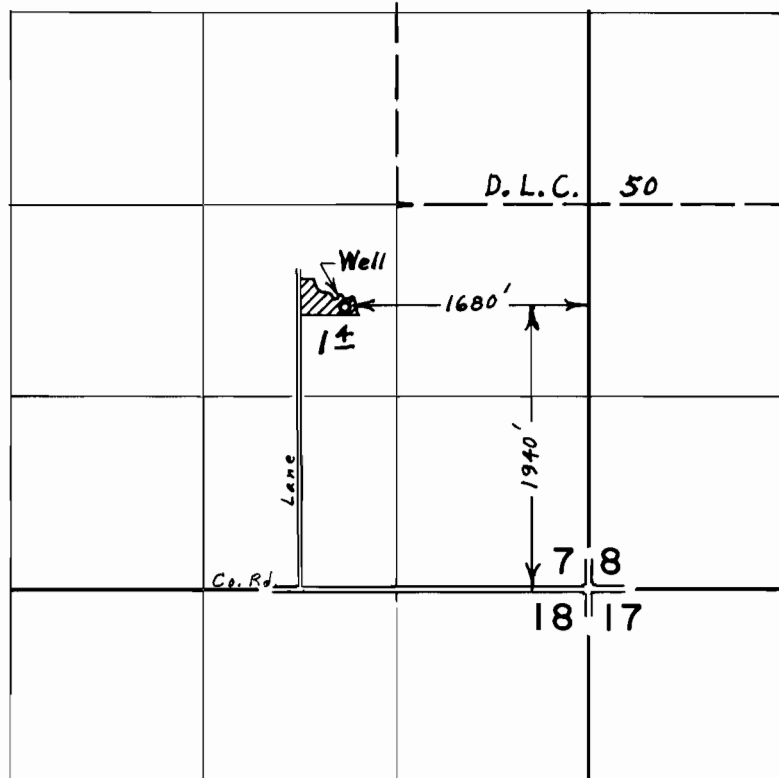

FINAL PROOF SURVEY UNDER

Application No. G-6633 Permit No. G-5689
IN NAME OF

DAVID E. PETERSON

Surveyed Sept. 8, 1976, by L. E. Gould