


T.2&3S. R.3E. W.M.

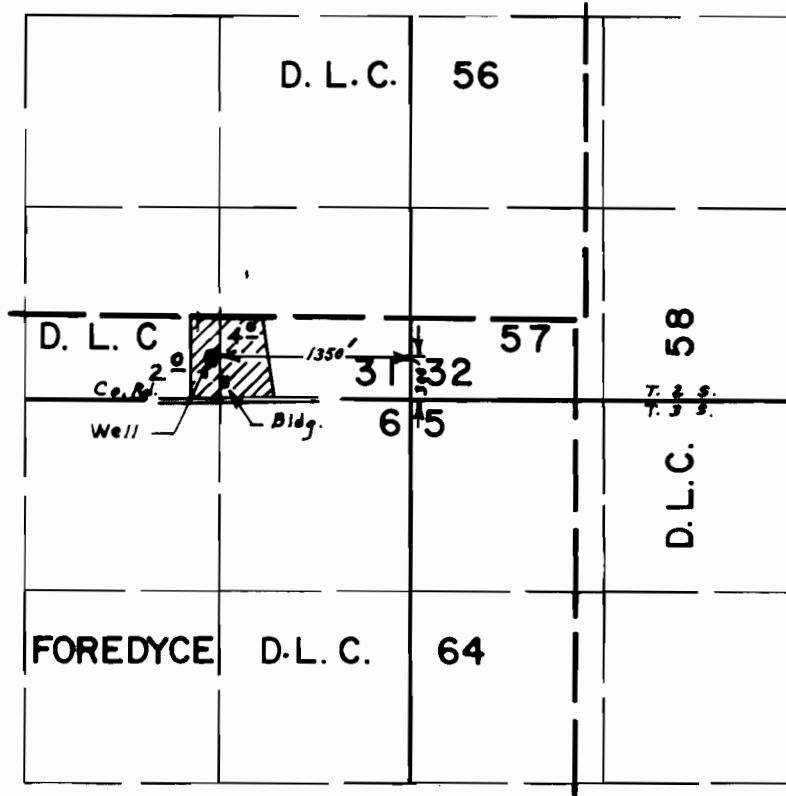

FINAL PROOF SURVEY UNDER

Application No. G-6054 Permit No. G-5752
IN NAME OF

MRS. JOHN DEININGER

Surveyed Sept. 10, 1976, by L. E. Gould