


# T.1 S. R.4 E. W.M.

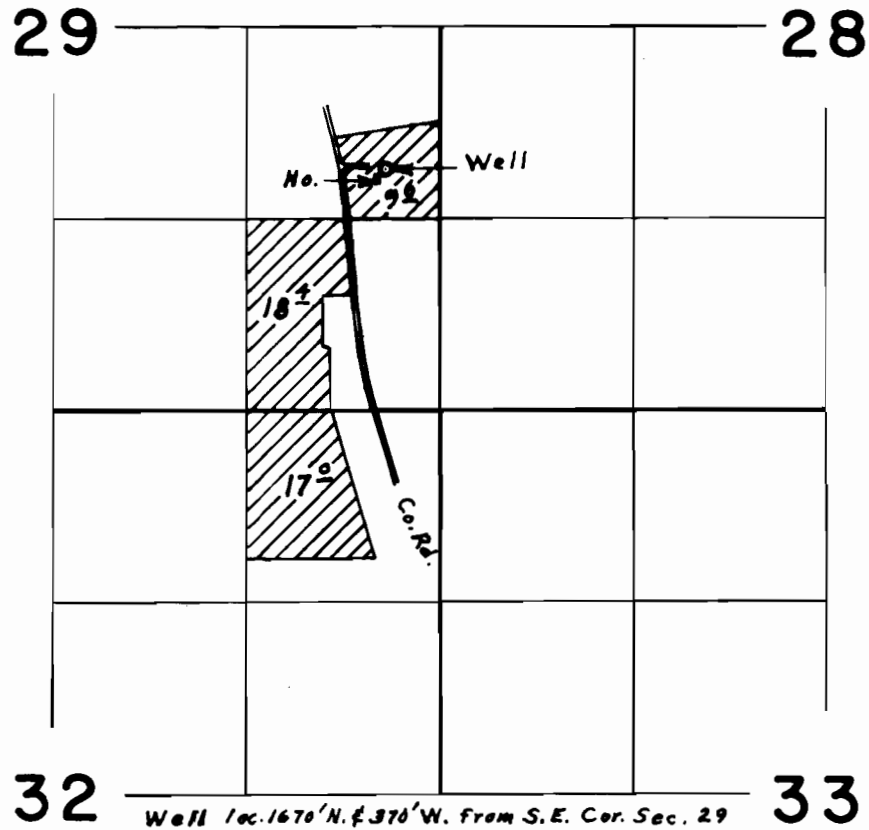

## FINAL PROOF SURVEY UNDER

Application No. G-6107 Permit No. G-5784  
IN NAME OF

JAMES R. BUSHUE

Surveyed Oct. 6, 1976, by L. E. Gould