


T.3 S. R.2 E. W.M.

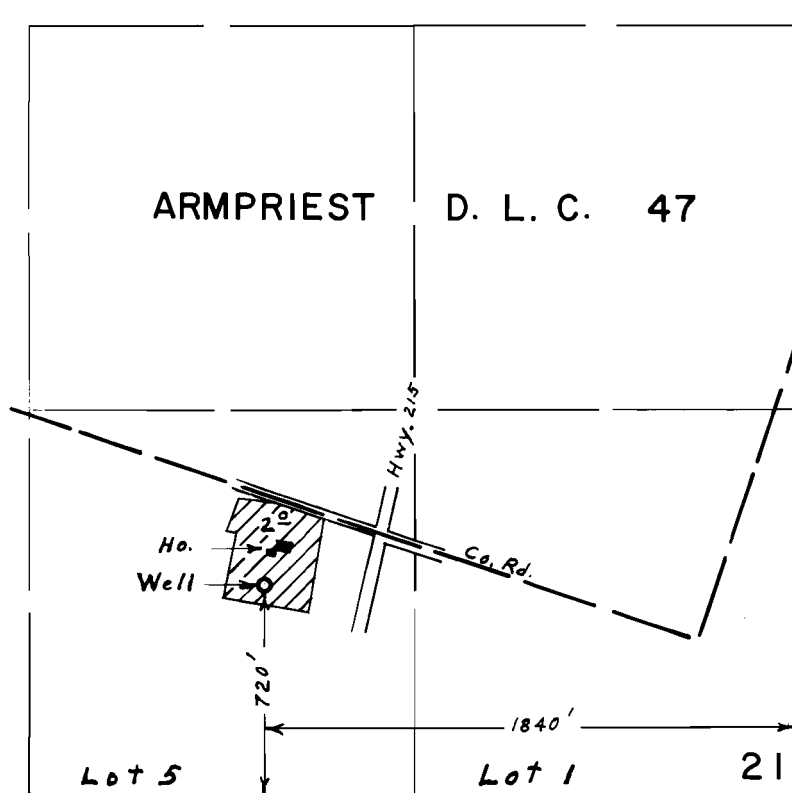

Scale 1" = 660'

FINAL PROOF SURVEY
UNDER

Application No. G-6674 Permit No. G-6227
IN NAME OF

DAVID & SUSAN KOBOS

Surveyed Aug. 20, 1976, by L. E. Gould.