


T.3 S. R.3 E. W.M.

30

NW $\frac{1}{4}$ NW $\frac{1}{4}$

NAIL

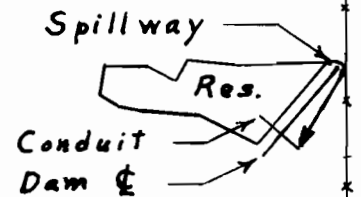

Div. Pt. located 520' S. & 70' W. from N.E. Cor. N.W. $\frac{1}{4}$ N.W. $\frac{1}{4}$ Sec. 30
Scale 1" = 200'

FINAL PROOF SURVEY
UNDER

R-49950 R-6095
Application No. 49951 Permit No. 37568
IN NAME OF

FRANKLIN MELLMER

Surveyed July 9, 1976, by L. E. Gould