


T.3.S. R.2 E. W.M.

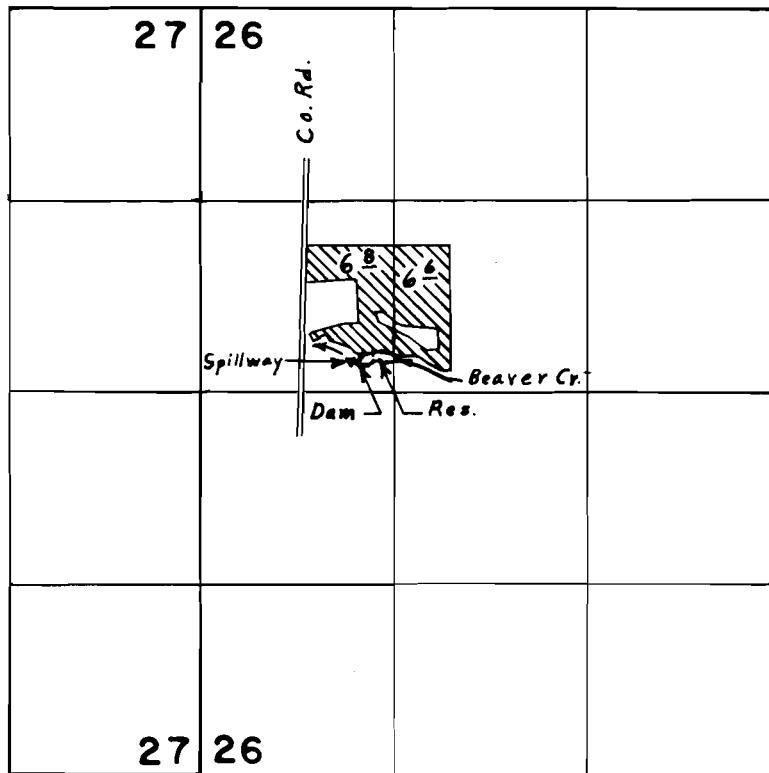

Div. Pt. 100' E. & 100' N. from W. $\frac{1}{4}$ Cor. Sec. 26

FINAL PROOF SURVEY
UNDER

R-53525 R-6395
Application No. 53526 Permit No. 39936
IN NAME OF

GEORGE D. & MARY J. VOTAW

Surveyed Aug. 17, 1976, by L. E. Gould