


T.6N. R.2W. W.M.

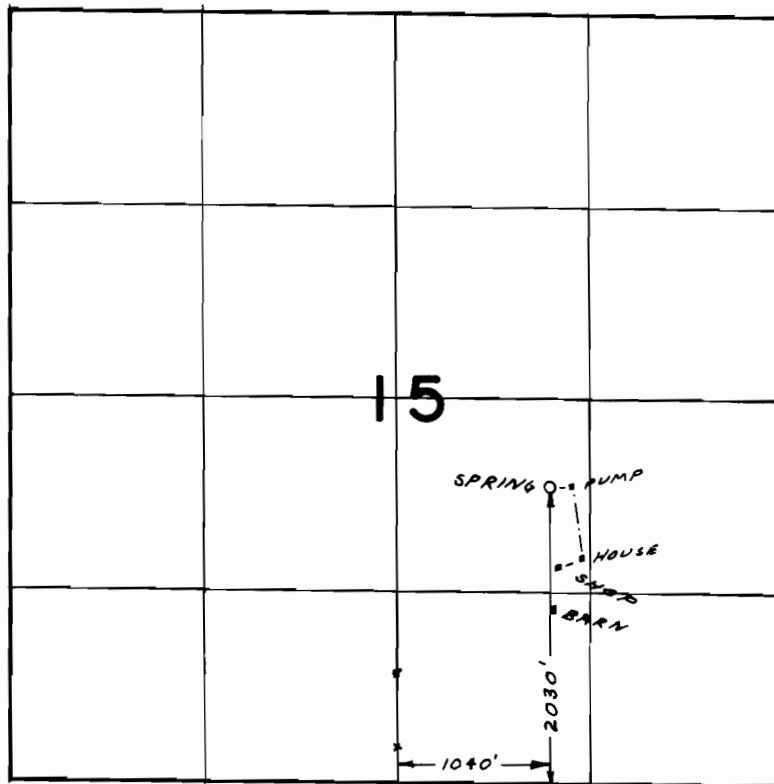

FINAL PROOF SURVEY
UNDER

Application No. 51379..... Permit No. 38850.....
IN NAME OF

THOMAS & MADELINE BARNES.....

Surveyed MAY 27 1976, by L.H. NUNN.....