


T. 36 S. R. 1 E. W.M.

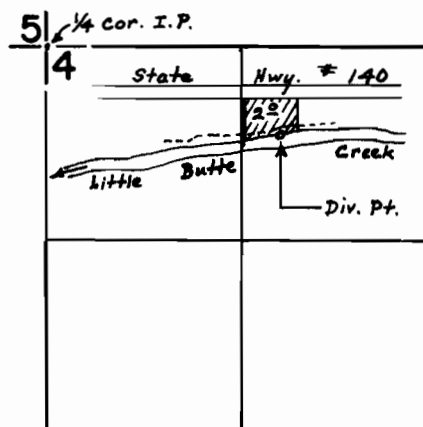

Div. pt. is 620' S & 1610' E from
the W 1/4 cor. of sec. 4

FINAL PROOF SURVEY
UNDER

Trans.No. W-124

Application No. _____ Permit No. _____
IN NAME OF

R.A. & B.R. WIES

Surveyed **Feb. 9** 1971, by **D.C. Hendrix**