


T.36S., R.4W., W.M.

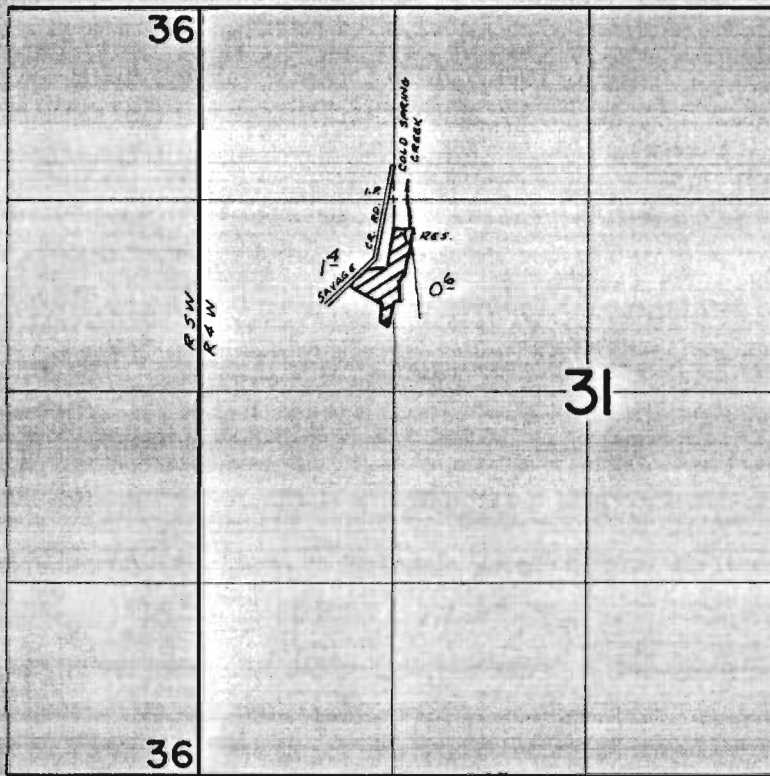

RES. LOC: 210'S & 100'E FROM NW COR. SE $\frac{1}{4}$ NW $\frac{1}{4}$ SEC 31

FINAL PROOF SURVEY
UNDER

R-47680 R-5744
Application No. 47681 Permit No. 35674
IN NAME OF

DAVID A. REED

Surveyed May 9 1975, by D. Norby