


T.18&19S.,R.5W.,W.M.

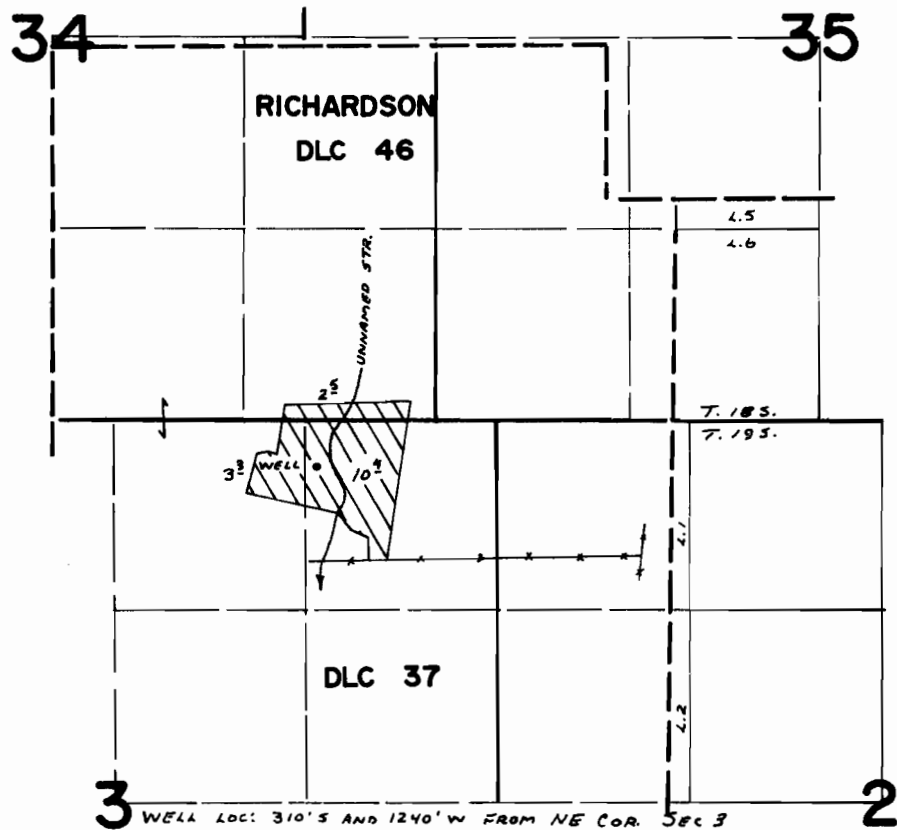

FINAL PROOF SURVEY

UNDER

Application No. **G-2342** Permit No. **G-2160**

IN NAME OF

**DAN & BETTY SMITH**

Surveyed **APRIL 17 19 75**, by **L. Toll**