


T.16S. R.5E. W.M

SEC. 14

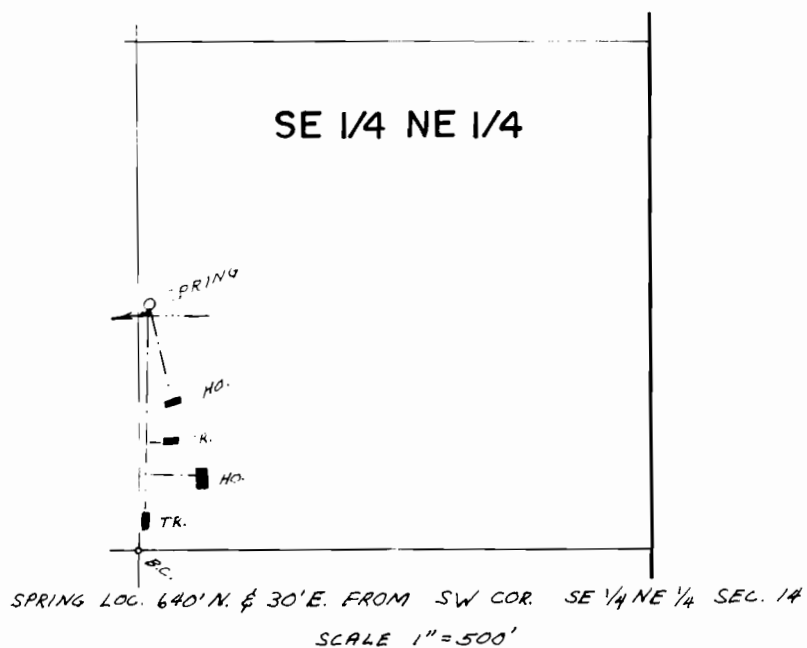

FINAL PROOF SURVEY
UNDER

Application No. 37988 Permit No. 28324
IN NAME OF

WALTER A. SACKS

Surveyed AUG. 30 1977, by L.H. NUNN