


T.13S.R.10W.W.M.

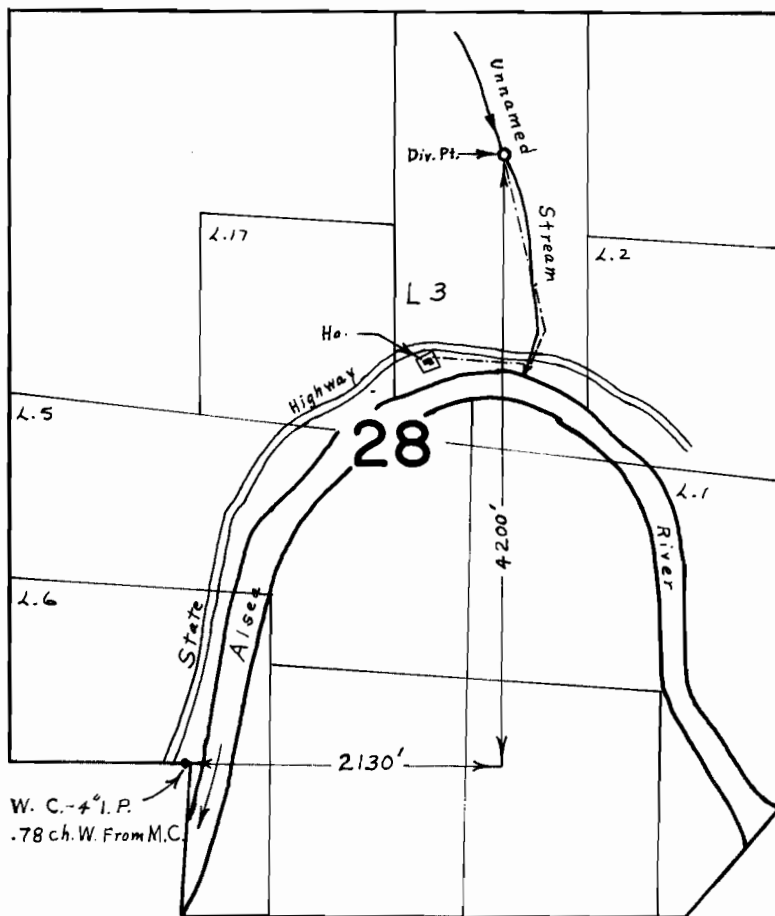

FINAL PROOF SURVEY UNDER

Application No. 43187 Permit No. 32286
IN NAME OF

HARRY & NANCY WILSON

Surveyed Aug. 24, 1966, by L. E. Gould
SEPT. 10 75 L. Toll