


T.13S. R.11W. W.M.

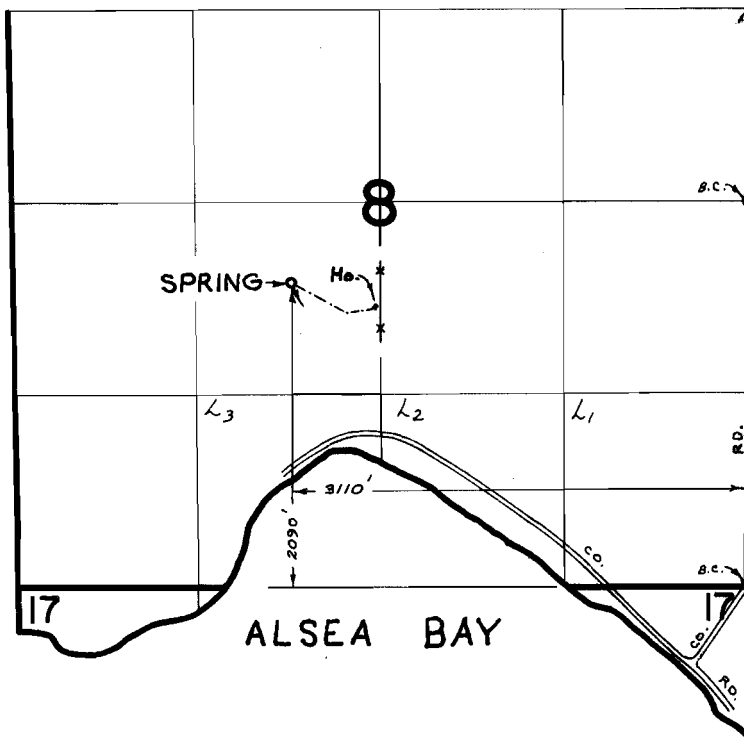

FINAL PROOF SURVEY

UNDER

Application No. 43680 Permit No. 32649
IN NAME OF _____

EDNA A. BALL

Surveyed SEPT. 11, 1975, by L. M. TOLL