


T.14S.,R.9W.,W.M.

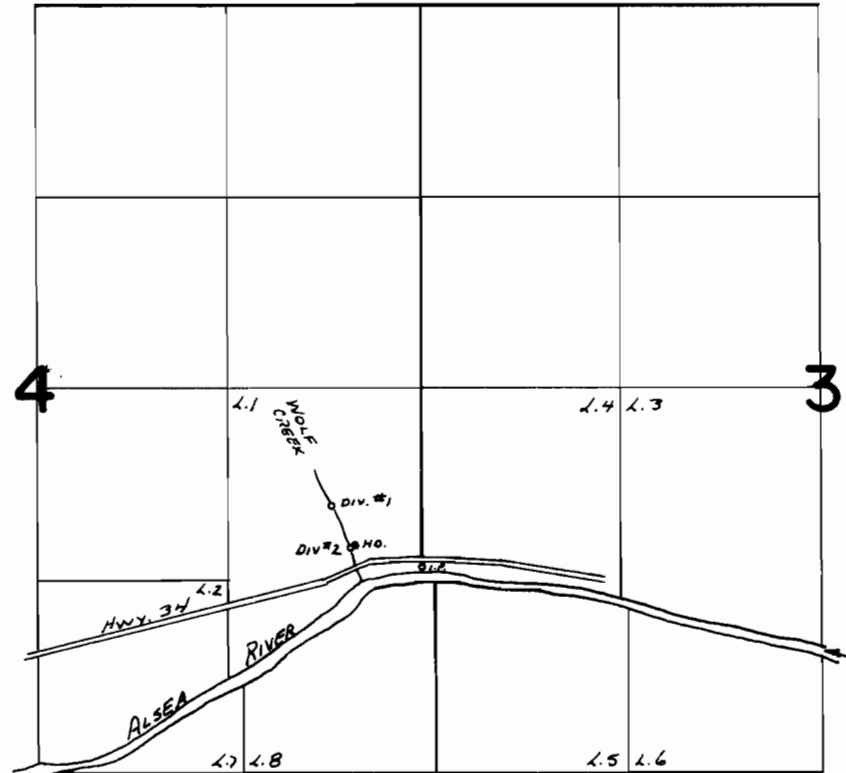

DIV #1 - 410' N AND 610' W } FROM M.C. AT SE COR. Lot 1 Sec. 4
 DIV #2 - 130' N AND 480' W }

FINAL PROOF SURVEY UNDER

Application No. 45205 Permit No. 33771
 IN NAME OF

WILLARD J. ROLOW

Surveyed SEPT. 12. 1975, by L. Toll