


T.10S.,R.10W.,W.M.

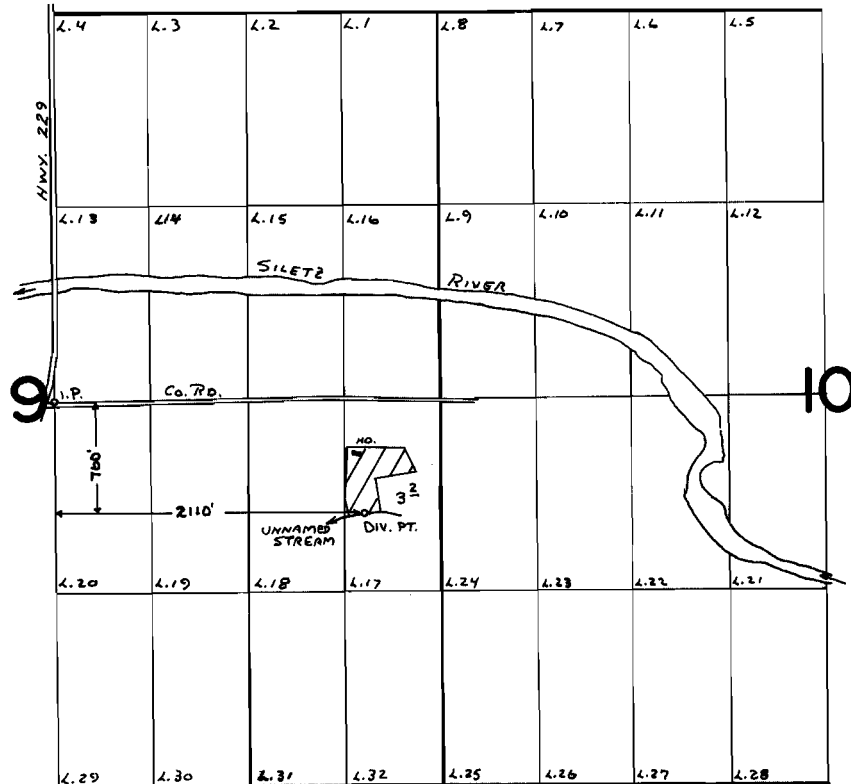

FINAL PROOF SURVEY
UNDER

Application No. 48444 Permit No. 36362
IN NAME OF

RALPH E. SOUTHWELL

Surveyed SEPT. 26 1975, by L. Tell