


T.13S.,R.10W.,W.M.

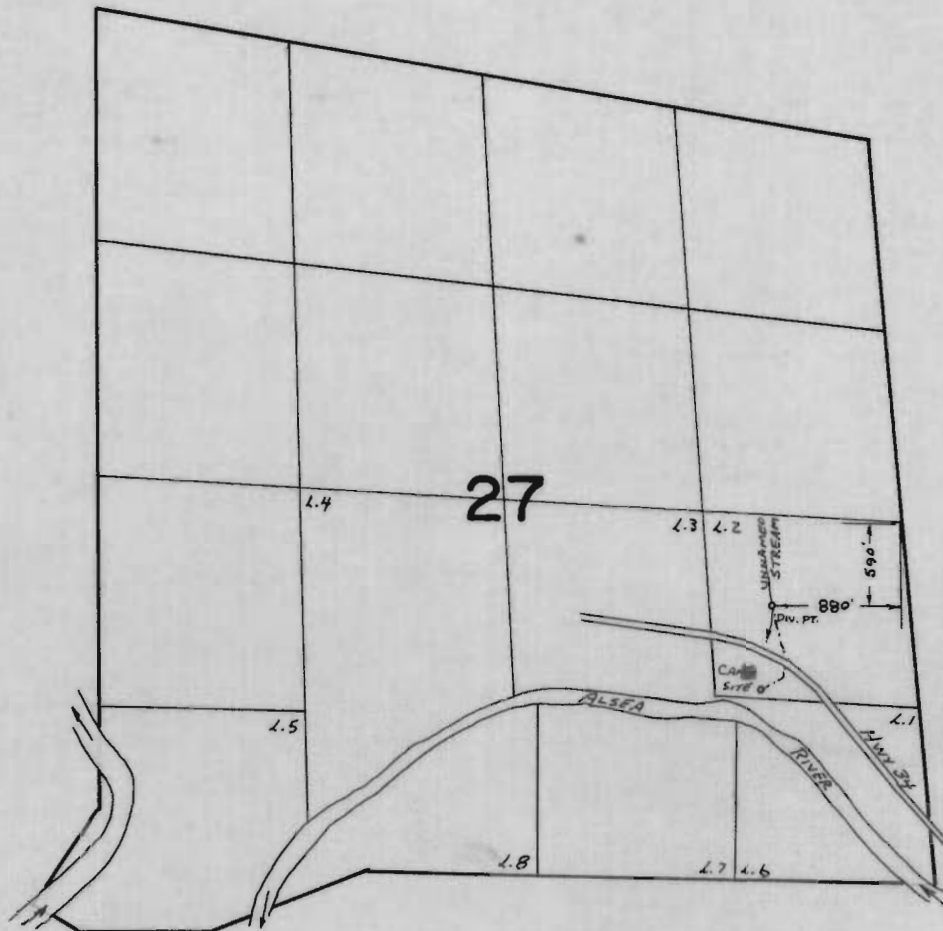

FINAL PROOF SURVEY
UNDER

Application No. 49372 Permit No. 37010
IN NAME OF

CHARLES R. COX

Surveyed SEPT. 10. 19.75. by L. Tall