


T.13S.,R.10W.,W.M.

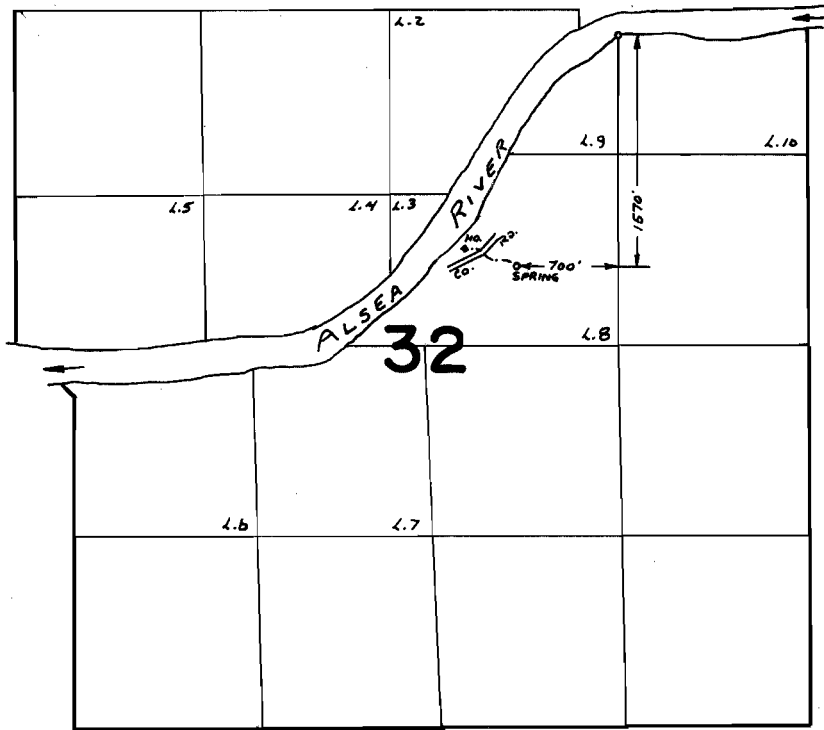

**FINAL PROOF SURVEY**  
UNDER

Application No. 49964 Permit No. 37374  
IN NAME OF

HERBERT CLAYTON DEWITT

Surveyed SEPT. 9 1915, by L. Tell