


T.11S., R.2W., W.M.

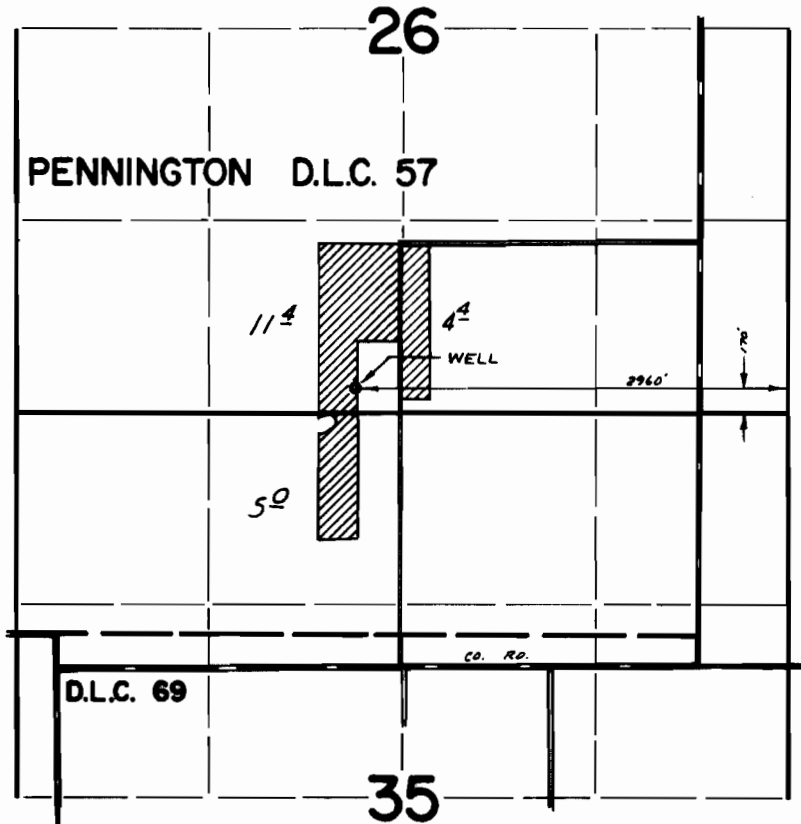

FINAL PROOF SURVEY
UNDER

Application No. G-3934 Permit No. G-3690
IN NAME OF

GEORGE HESSONG

Surveyed June 19, 1973, by D. Norby
Sept. 3, 1975, by D. Norby