


# T.15S.,R.4W.,W.M.

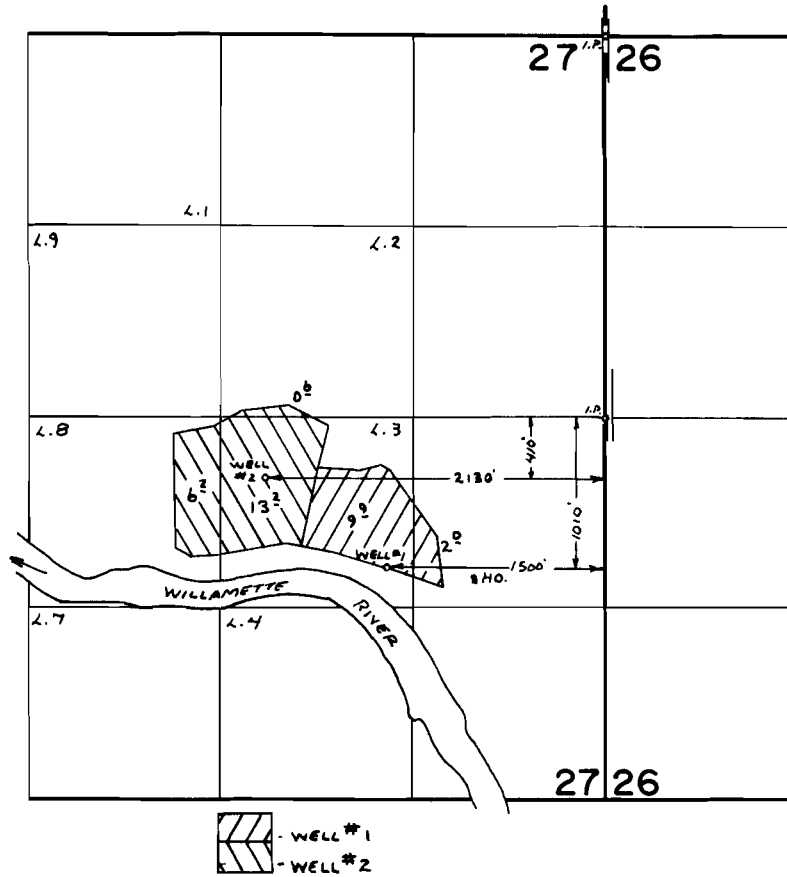

## FINAL PROOF SURVEY UNDER

Application No. G-5121 Permit No. G-4859  
G-5122 Permit No. G-4860  
IN NAME OF

GEORGE STRODA

Surveyed July 28 1975, by L. Tell