


T.13S.,R.1W.,W.M.

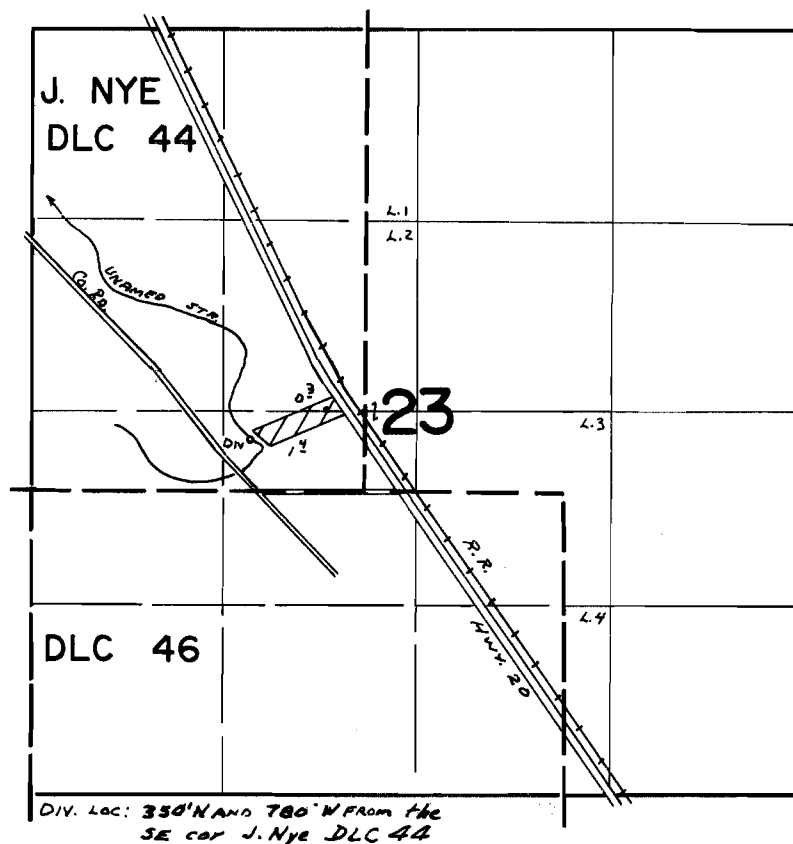

**FINAL PROOF SURVEY**  
UNDER

Application No. 40050 Permit No. 29855  
IN NAME OF

GERALD D. HORTON

Surveyed July 3, 1975 by L. Toll