


T.9S.,R.3E.,W.M.

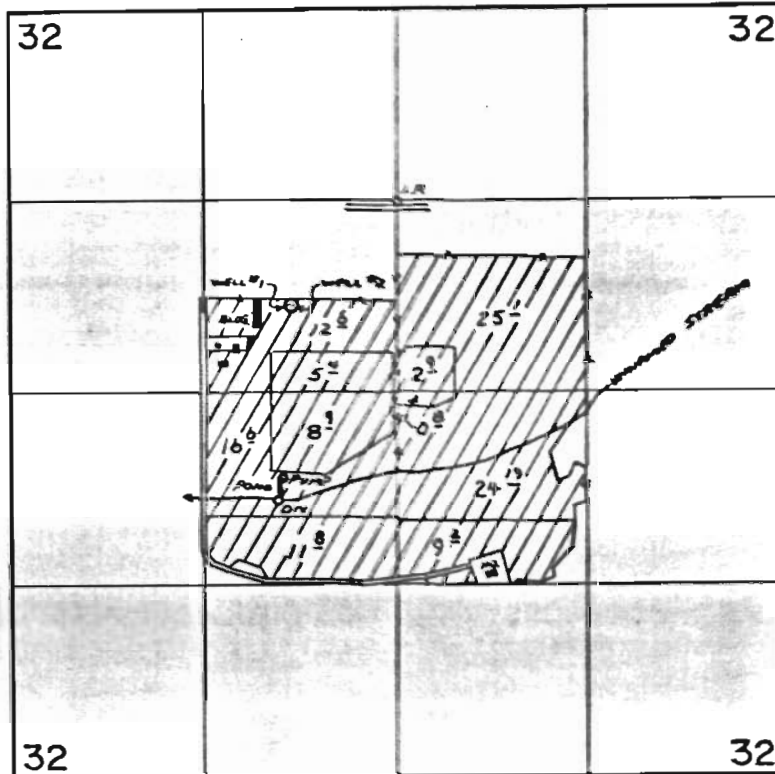

DIV. LOC: 2050'S AND 810' W
WELL #1: 710'S AND 740' W } FROM NE COR SE 1/4 SEC 32
WELL #2: 710'S AND 720' W }

FINAL PROOF SURVEY
UNDER

Application No. 47804 Permit No. 35810
G-5379 G-4967
IN NAME OF

DONALD C. WALKER

Surveyed April 23 1975, by L. Tall