


# T.13S.,R.3W.,W.M.

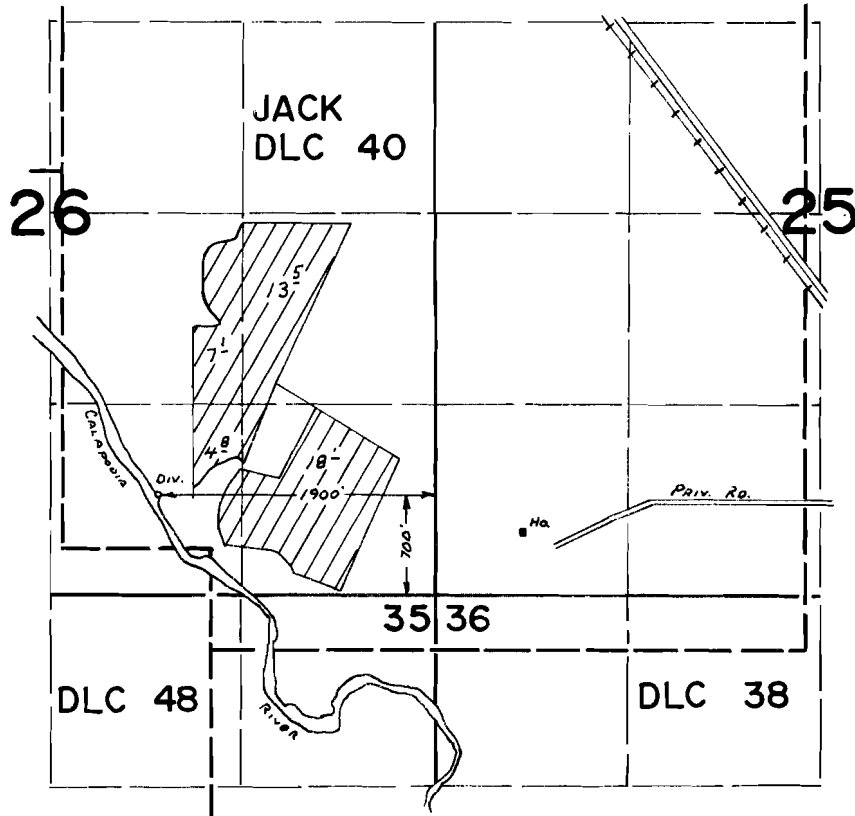

## FINAL PROOF SURVEY UNDER

Application No. 45915 Permit No. 34303  
IN NAME OF

THOMAS R. & COZETTA JAMES

Surveyed July 1 1975, by L. Toll