


T.14S., R.1E., W.M.

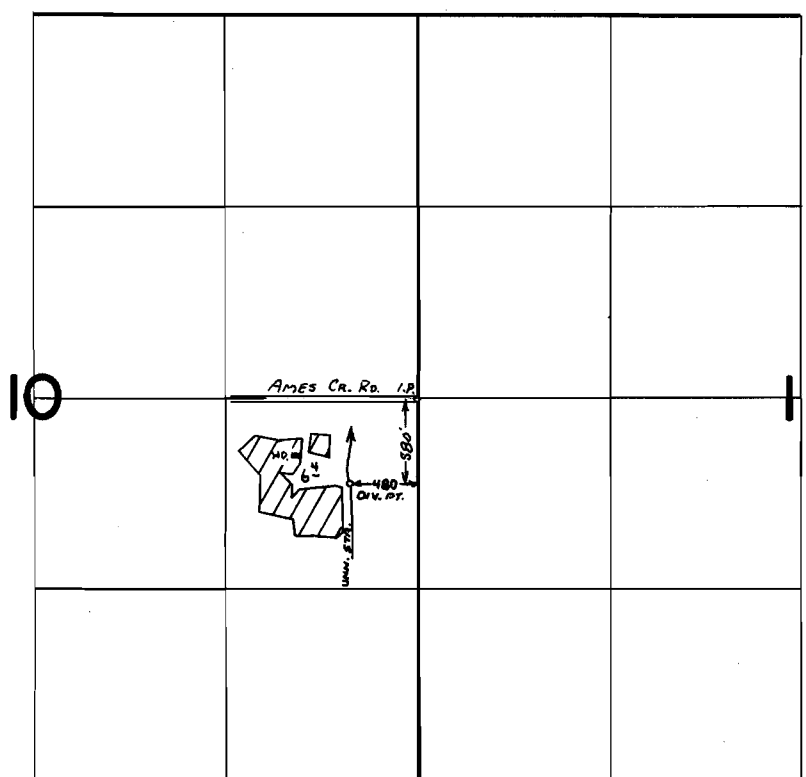

FINAL PROOF SURVEY
UNDER

Application No. 48167 Permit No. 36185
IN NAME OF

JOHN K. SEIBERT

Surveyed June 2, 1975, by A. Tall