


T.13S.,R.1W.,W.M.

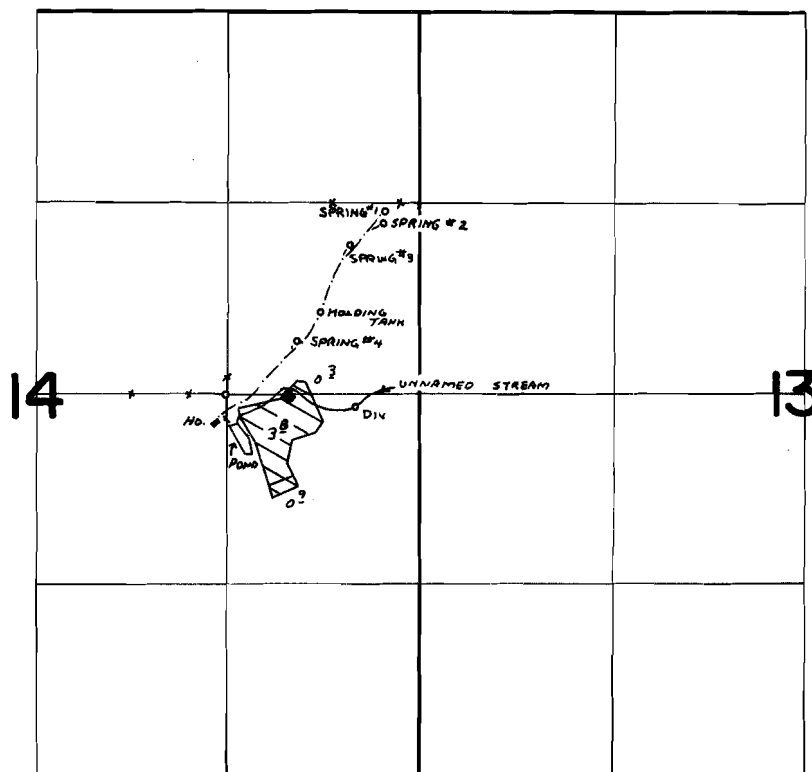

SPRING 1 - 1270' N AND 1070' E }
 SPRING 2 - 1190' N AND 1060' E }
 SPRING 3 - 1030' N AND 840' E }
 SPRING 4 - 370' N AND 480' E } ALL FROM NE COR NW SE OF SEC 14
 DIV. PT. - 80' S AND 880' E
 DAM - 200' S AND 20' E

FINAL PROOF SURVEY UNDER

Application No. R-48827 48828 Permit No. R-5923 36596
 IN NAME OF

A. O. RICKMAN

Surveyed Aug. 1 1975, by L. Toll