


T.12S.,R.1W.,W.M.

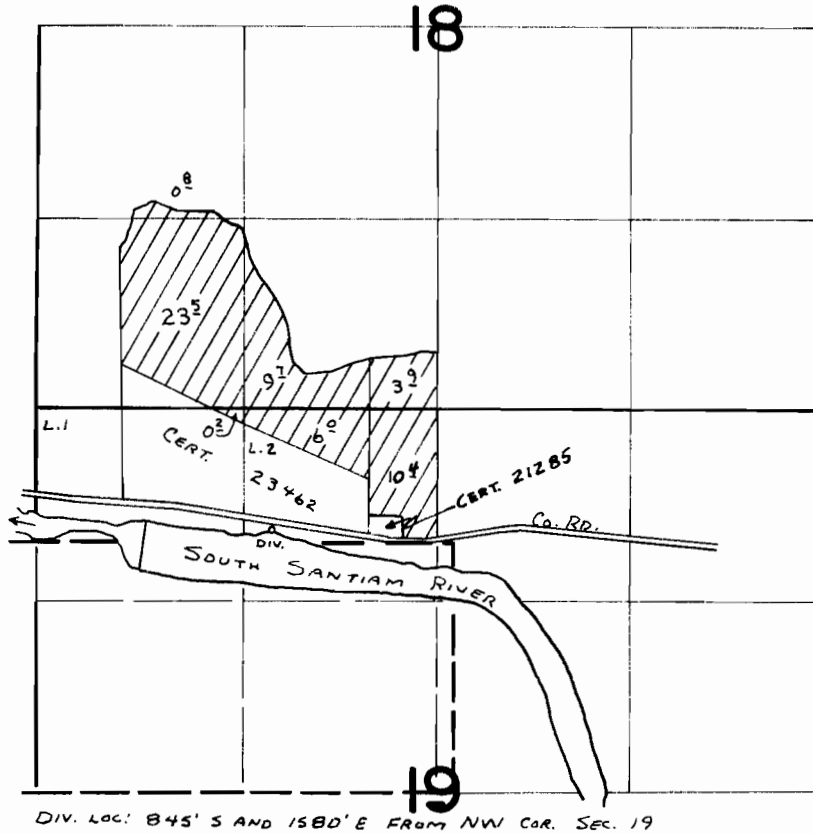

**FINAL PROOF SURVEY**  
UNDER

Application No. 56971 Permit No. 42843  
49580 37206  
IN NAME OF

RUSSELL C. ROSE

Surveyed May 27 1975, by L. Toll  
Sept. 8 1978 J.S. DONALDSON