


T.14S.,R.1W.,W.M.

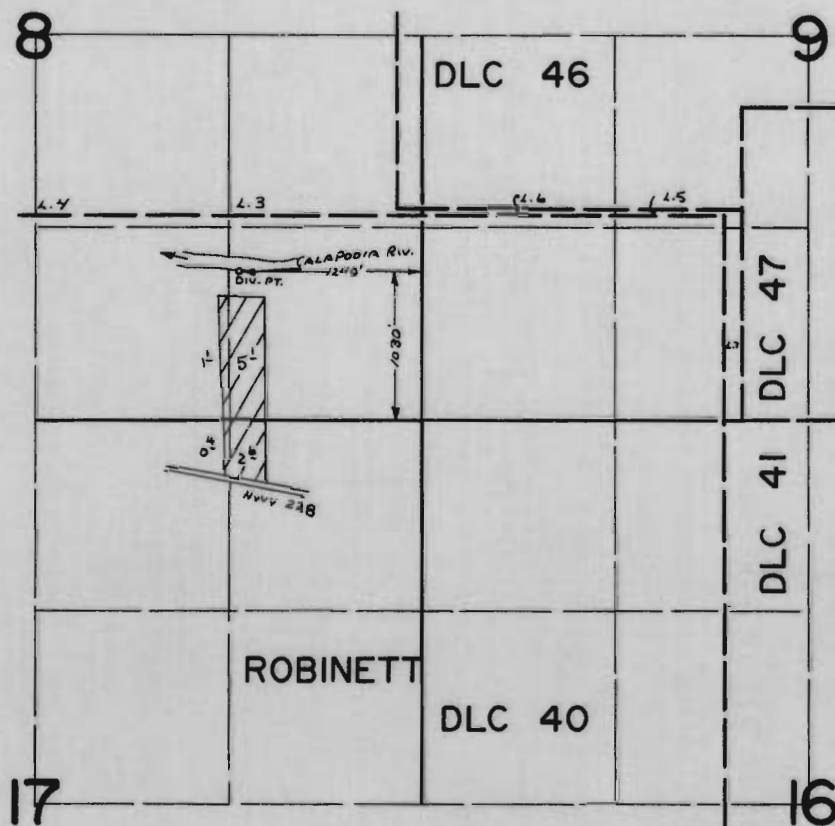

FINAL PROOF SURVEY UNDER

Application No. 51751 Permit No. 37521
IN NAME OF

Johnny Littlefield

Surveyed July 2, 1975, by L. Tall